



Summer Co

Map No. Kaw Sec. 8 Twp. 30 R. 2W


Well No. # 1 Latta Farm  
Champlain Oil Company

990 Ft. from N. Line

\_\_\_\_\_ Ft. from S. Line

\_\_\_\_\_ Ft. from E. Line

990 Ft. from W. Line

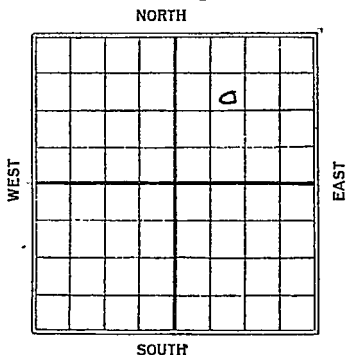

Date	REPORT
1925	
<del>6/10</del>	<del>Rig.</del>
6/5	<del>70.0</del>
7/22	Gas 1921-24 - 1 MI
	Gas 3-MI: 1925-38
	H.F.W. 1938-50'
8/7	10" 1960 July 2380'
8/14	2500' H.F.W.
<del>8/17</del>	2560'
8/27	8" - 2870'
9/2	Qaw. Line 3068-70-1000'
	oil in hole.
	July 3150
9/9	6" 3175 July 3210'
	show oil 3182-3203 went
	into H.F.W.
9/20	Show gas 3464-3466. Top line 3688
	TDS 2700 fusing casing
10/6	r
10/13	_____
10/21	_____
10/28	_____

1/4" jag pipe @ 3700'

1/1" drlg by pipe  
3700'

1/8" set 3" @ 3701 drlg @ 3710

1426

1/3 - J. D. 4153<sup>s</sup> L M, D + A.

*Summer*

Map No. **KANSAS** Sec. *8* Twp. *30* R. *2W*

Well No. *#1 Latta*

*Champlain Oil & R* Company

Contractor

**FIRST REPORT**

**SECTION PLAT**

*990* Ft. from N. Line

\_\_\_\_\_ Ft. from S. Line

\_\_\_\_\_ Ft. from E. Line

*990* Ft. from W. Line

		①	

Location \_\_\_\_\_

Rig up \_\_\_\_\_

Drilling and Remarks:

*Rig*

**RECORD**

Cased \_\_\_\_\_ in., \_\_\_\_\_ ft.

Sand \_\_\_\_\_

Gas \_\_\_\_\_

Oil \_\_\_\_\_

Total Depth \_\_\_\_\_

**PRODUCTION**

1st 24 hrs. Nat. \_\_\_\_\_

1st 24 hrs. after shot \_\_\_\_\_

Gas \_\_\_\_\_ *157* Cu. Ft.

Dry Hole \_\_\_\_\_

Abandoned \_\_\_\_\_

Date

**JUN 5 1925**

**M. A. BENEAR**

Returned	
Cards	<i>MB</i>
Tracing	
France Map	
Scarborough Map	
Moody Map	
Scarborough Plat Book	
Moody Plat Book	

*no wall map*

MAP No. \_\_\_\_\_ SEC. 8 TWP. 30S R. 2W

WELL No. 1 A Little

Champion

COMPANY

CONTRACTOR

SECTION PLAT

		o	

\_\_\_\_\_ FT. FROM N. LINE

\_\_\_\_\_ FT. FROM S. LINE

\_\_\_\_\_ FT. FROM E. LINE

\_\_\_\_\_ FT. FROM W. LINE

LOCATION \_\_\_\_\_

RIG UP \_\_\_\_\_

DRILLING AND REMARKS:

*see sheets  
see map*

RECORD

CASED \_\_\_\_\_ IN., \_\_\_\_\_ FT.

SAND \_\_\_\_\_

GAS \_\_\_\_\_

OIL \_\_\_\_\_

TOTAL DEPTH 415'

PRODUCTION

1ST 24 HRS. NAT. \_\_\_\_\_

1ST 24 HRS. AFTER SHOT \_\_\_\_\_

GAS \_\_\_\_\_ CU. FT.

DRY HOLE

ABANDONED

DATE

1/12 1926

SCOUT

*Sumner*  
Map No. **KANSAS** Sec. *8* Twp. *30* R. *24*

Well No. *1 Latta*

*Champlain Ref.* Company

Contractor

SECTION PLAT

		0	

*990* Ft. from N. Line

----- Ft. from S. Line

----- Ft. from E. Line

*990* Ft. from W. Line

**ABANDONED**

RECORD

Location -----

Rig up -----

Drilling and Remarks:

*T 4153 BHM*  
*D & A.*

Cased ----- in., ----- ft.

Sand -----

Gas -----

Oil -----

Total Depth -----

PRODUCTION

1st 24 hrs. Nat. -----

1st 24 hrs. after shot -----

Gas ----- Cu. Ft.

Dry Hole -----

Abandoned -----

Date

*JAN 13 1926*

**S. J. LEWIS**

Scout

Returned	
Cards	<i>J</i>
Tracing	<i>no tracing</i>
Trance Map	<i>no wall map</i>
Scarborough Map	<i>J</i>
Moody Map	<i>no wall map</i>
Scarborough Plat Book	
Moody Plat Book	

*Wall map now*