


Section 8 Township 30 Range 2W

Well No. #4 Latta

Company J. J. Lynn

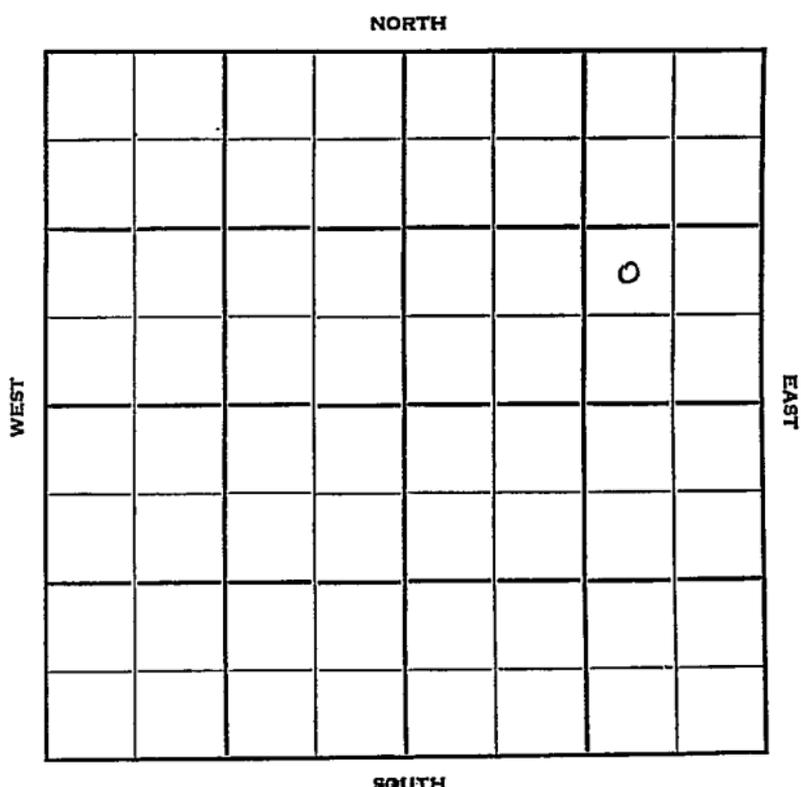

Sec. 8 Twp. 30 R. 2W

Well No. #4 Latta Farm

J. J. Lynn Company

Williams - Contr. Contractor

Latta Pool

Ft. from N. Line

990'


Ft. from S. Line

990'

Ft. from E. Line

Ft. from W. Line

NW SE NE

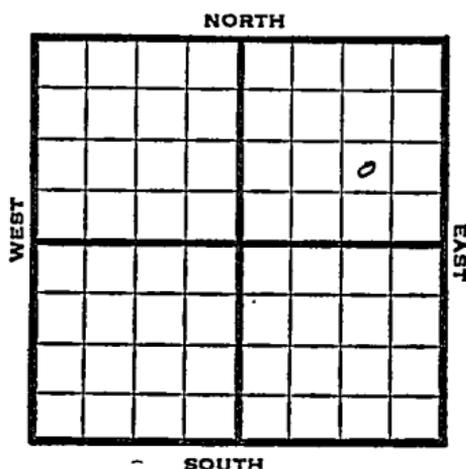

1950

Elev. 1355' REPORT

12/6

Location

1951

2/21

Oil Well TD 3260
8" @ 192 5" @ 3260
KC 3055
DST 3150-65 opn 1/2 hr Rec. 60' ocm
300' mud & wtr DST 3180-87
opn 1/2 hr Rec. 30' so&GCM
300' sw DST 3207-30 opn 1 hr
Rec. 270' ho & gcm 60' oil,
mud & wtr
TD 3260 20/3215-20 500 A
Comp. 4 bopd

COMPLETE

DEC 2 1958

Scout Cards	
Land Small Map	
Land Wall Map	
Tracings	
France Map	
Pierre Map	
Misc.	

Scout Cards
Land Small Map
Land Wall Map
Tracings
France Map
Pierce Map
Misc.

APR 26 1957