
DX 78-1

Kingman KANSAS

Section 8 Township 30 Range 7W

Well No. 1 Johnson

Company R. E. Hartman

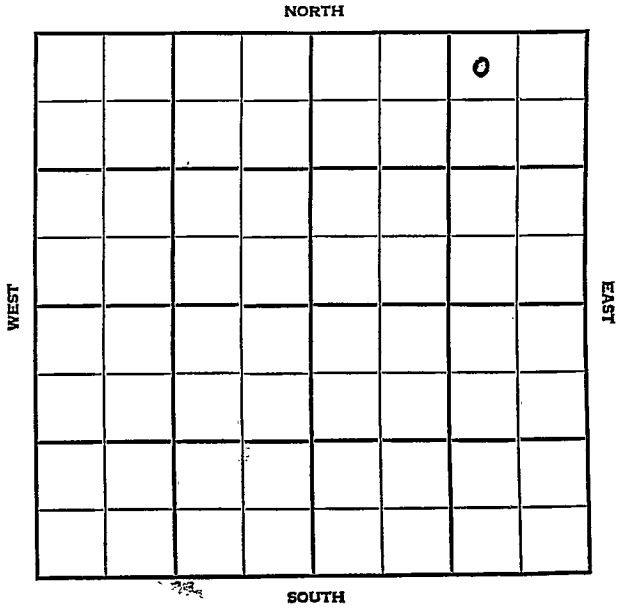

Kingman KANSAS

SEC.	TWP.	R.
8	30	7W

WELL NO. 1 Johnson FARM

COMPANY R. E. Hartman

CONTRACTOR A. L. Jackson

Wildcat


330 Ft. from N. Line

Ft. from S. Line

990 Ft. from E. Line

Ft. from W. Line

NW NE NE

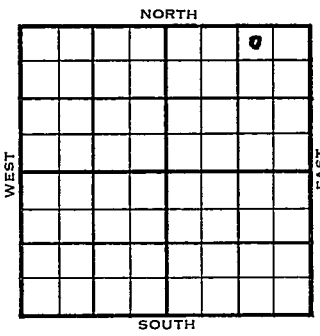

	ELEVATION	REPORT
1955	1474'	
3/23		Spud 3-17-55 8" @ 194' Drlg. 2370'
4/6		Spud 3-17-55 D & A TD 4235' 8" @ 194' Heeb 3093', Lans 3327' KC 3612' Miss 4136' DST 4137'-95' opn ½ hr, rec 20' Mud, 160# TD 4235' D & A ABANDONED

DX-78

FORM 275 FOR SALE BY KANSAS BLUE PRINT CO.


County Kingman State Kansas

Sec. 8 (Blk. Twp.) 30 (Sur. Rge.) 7W Map No.

Operator R. E. Hartman

Well No. 1 Farm Johnson

Elev. 1474 Location NW NE NE

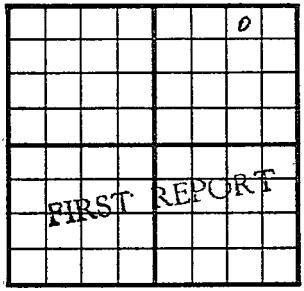

330 Ft. From N Line NE

990 Ft. From E Line Quarter

1st. Report MAR 23 1955

Completion

Remarks A.L. Jackson - Contr.

Spudding Date 3-17-55

Drlg. Data Wildcat

8" @ 194 drlg. 2370

FABEN GILSTRAP

FORM 275 FOR SALE BY KANSAS BLUE PRINT CO.


County Kingman State Kansas

Sec. 8 (Blk. Twp.) 30 (Sur. Rge.) 7W Map No.

Operator R. E. Hartman

Well No. 1 Farm Johnson

Elev. 1474 Location NW NE NE

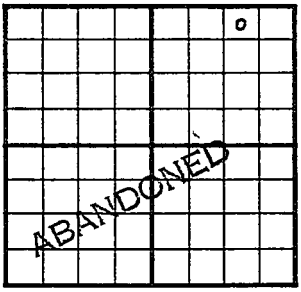

330 Ft. From N Line NE

990 Ft. From E Line Quarter

1st. Report

Completion APR 6 1955

Remarks Wildcat

A.L. Jackson - Contr.

Spudding Date 3-17-55

Drlg. Data D & A TD 4235

8" @ 194 Heeb. 3093 Lans. 3327

KC 3612 Miss. 4136 DST 4137-95

open ½ hr. Rec. 20' mud 160# TD 4235

D & A

FABEN GILSTRAP