


DX 78-1

Kingman KANSAS

Section 8 Township 30 Range 8W

Well No. 1 Bramwell

Company O. A. Sutton

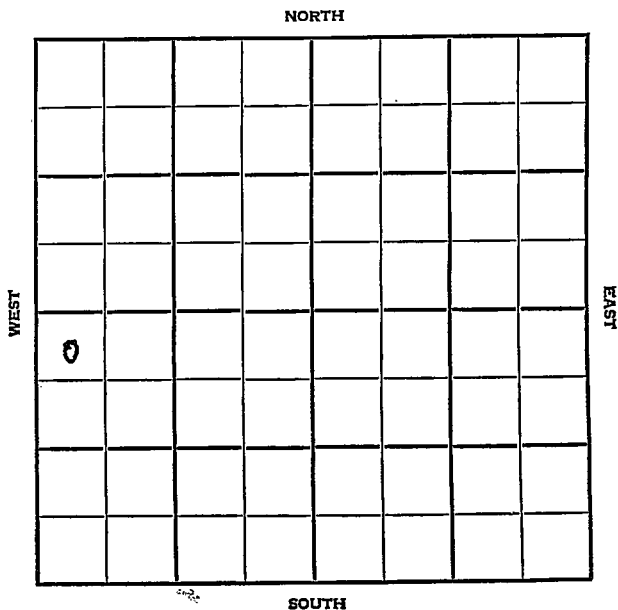

Kingman KANSAS

SEC.	TWP.	R.
8	30	8W

WELL NO.

1 Bramwell

FARM

COMPANY

O. A. Sutton

CONTRACTOR

Jackson


Zenda Pool

330 Ft. from N. Line

Ft. from S. Line

Ft. from E. Line

330 Ft. from W. Line

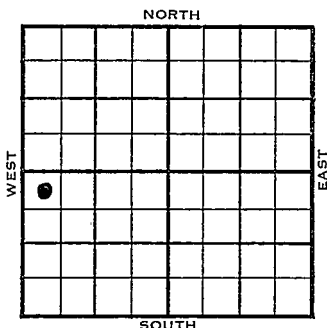

NW NW SW

ELEVATION

REPORT

1955

4/20

Spud 4-15-55
8" @ 193'
rlg. 1958'

County	Kingman	State	Kansas
Sec.	8	(Blk. Twp.) 30	(Sur. Rge.) 8W Map No.
Operator	O. A. Sutton		
Well No.	1	Farm	Bramwell
Elev.	Location NW NW SW		

0

FIRST REPORT

330 Ft. From	N Line	SW
330 Ft. From	W Line	Quarter
1st. Report	APR 20 1955	
Completion		

Remarks

Jackson - Contr.

Spudding Date 4-15-55

Drlg. Data Zenda Pool

8" @ 193 drlp. 1958

FABEN GILSTRAP