

KANSAS


FORM 51 5M 1-42 PETROL

Kingman

Section 8 Township 30 Range 8-W

Well No. #1 Ralls

Company Vickers

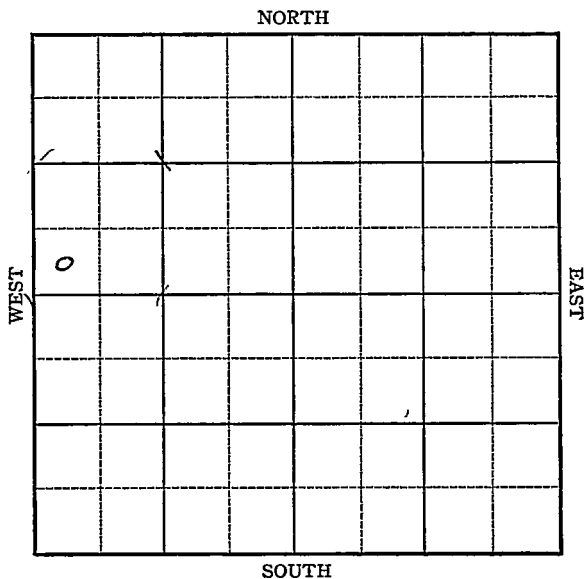


KANSAS

Kingman

Sec. 8 Twp. 30 R. 8-W

Well No. #1 Ralls Farm

Vickers Company

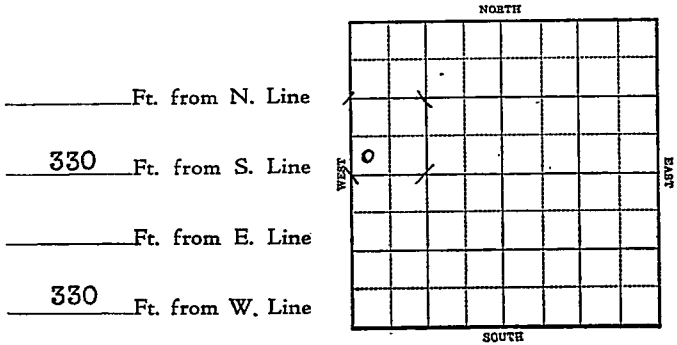

1943 1531? R E P O R T

9/29	Location	
10/6	10" @ 320'	
	Drlg. 370'	
10/13	Drlg. 2850'	
10/20	Rt Riley 1600	4648
	Neva 2130	3117
	Lans 3439	1531
	Drlg. 3980'	
10/27	Miss 4163	4532
	Kind 4353	1531
	Drlg. 4450	3001
11/3	Viola 4478	
	Imp 4532	4163
	Arb 4648	1531
	T.D. 4700'	2632

ABANDONED

KANSAS

Kingman


Map No. 36 Sec. 8 Twp. 30 R. 8WWell No. 1 KallsVickers Company

FIRST REPORT

Contractor

SW NW

SECTION PLAT

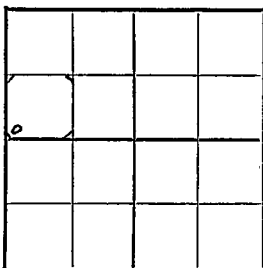 Ft. from N. Line330 Ft. from S. Line Ft. from E. Line330 Ft. from W. LineWildcatLocation XRig up

Drilling and Remarks:

RECORD

Cased in., ft.Sand Gas Oil Total Depth

PRODUCTION

1st 24 hrs. Nat. 1st 24 hrs. after shot Gas Cu. Ft.Dry Hole Abandoned

Date

SEP 29 1943 19

S. J. LEWIS Scout

Map No. NSAS 36 Sec. 8 Twp. 30 R. 8W

Well No. 1 Ralls

Vickers Company

ABANDONED Contractor

SW NW

SECTION PLAT

6			

 Ft. from N. Line

330 Ft. from S. Line

 Ft. from E. Line

330 Ft. from W. Line

Wildcat

Location

Rig up

Drilling and Remarks:

Vista 4478
Simp 4532
Per 4548

RECORD

Cased in., ft.

Sand

Gas

Oil

Total Depth 4700

PRODUCTION

1st 24 hrs. Nat.

1st 24 hrs. after shot

Gas Cu. Ft.

Dry Hole

Abandoned

Date

NOV 3 1943 19 S. J. LEWIS Scout