

Stanton


KANSAS

SECTION 8 TOWNSHIP 30 RANGE 42W

WELL NO. #1 Bitner

COMPANY Graham-Michaelis, Skelly & Kellum-Hurd

NORTH C SW/4

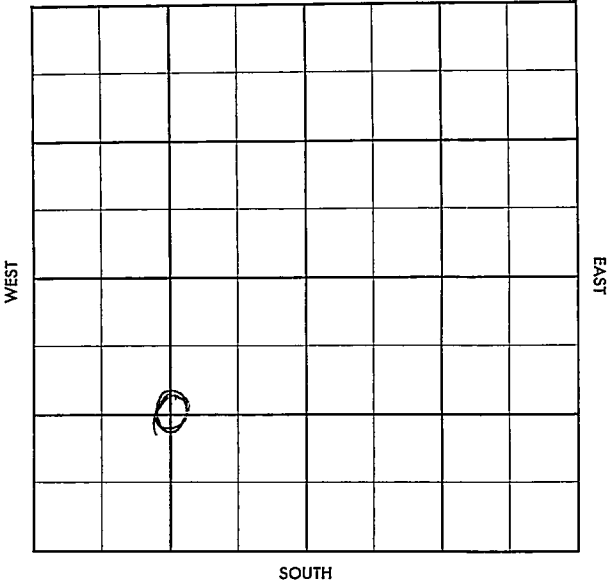

Stanton

KANSAS


SEC.	TWP.	R.
8	30 S	42 W

WELL NO. # 1 Bitner FARM

COMPANY Graham-Michaelis, Skelly, Kellum-Hurd

CONTRACTOR Graham-Michaelis Tools  
Semi WC-Ext. to Sparks

\_\_\_\_\_ FT. FROM N. LINE  
 \_\_\_\_\_ FT. FROM S. LINE  
 \_\_\_\_\_ FT. FROM E. LINE  
 \_\_\_\_\_ FT. FROM W. LINE

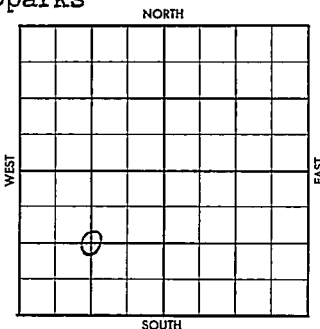

G SW/4

SDX-1/4 Mile United Prod.-DHM

1957	ELEVATION	REPORT
------	-----------	--------


6/26

Comm. 6-21-57  
Rng. 8". TD 1557'

County Stanton Elev.             
 Sec. 8 Twp. 30 Rgs. 42W  
 Company Graham-Michaelis, Skelly, Kellum-Hurd  
 FarmName Bitner No. 1

TOPS	DEPTH	LOG	DATUM
Anb.			
Tp.			
H.			
Tr.			
Dg.			
Bl.			
L.			
K.C.			
B.K.C.			
Ce.			
C.			
M.			
M.			
K.			
Mz.			
Mq.			
V.			
S.			
S.			
A.			
R.			
Pe.			
G.			
T.D.			

Loc. in Sec. C SW/4  
 Geol.             
 Contr. Graham-Michaelis Tools  
 Pool Semi WC-Ext  
Sparks

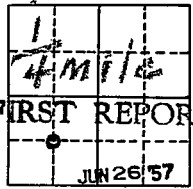

Date Comm. 6-21-57 United Producing-DHM  
ring 8", TTD 1557

W 4

Co.  
 No.  
 Sec.  
 T.  
 R.

Co.


County Stanton Elev. 3501 DE  
8 30 42W

Graham-Michaelis, Skelly, Kellum-Hurd  
Bitner No. 1

TOPS	DEPTH	LOG	DATUM
Anb. <u>W26</u>	<u>2930</u>	<u>2930</u>	
Fp. <u>elm</u>	<u>3120</u>	<u>3118</u>	
H. <u>TP</u>	<u>3277</u>	<u>3272</u>	
Tr. <u>Le op</u>	<u>3406</u>	<u>3405</u>	
Dg. <u>H6</u>	<u>3530</u>	<u>3528</u>	
Bl. <u>TR</u>	<u>3517</u>	<u>3566</u>	
L. <u></u>	<u>3685</u>	<u>3683</u>	
K.C. <u>Marm</u>	<u>4210</u>	<u>4197</u>	
B.K.C. <u>MW</u>		<u>4963</u>	
Co. <u>"sdy L1</u>		<u>5227</u>	
C. <u>Keyes</u>		<u>5304</u>	
M. <u>chest</u>		<u>5374</u>	
M. <u>st Gen</u>		<u>5393</u>	
K. <u></u>			
Mz. <u></u>			
Me. <u></u>			
V. <u></u>			
S. <u></u>			
S. <u></u>			
A. <u></u>			
R. <u></u>			
PE. <u></u>			
G. <u></u>			
T.D. <u></u>	<u>5475</u>	<u>5473</u>	

Loc. in Sec. C SW/4  
 Geol.   
 Contr. Graham-Michaelis Tools

Pool Semi WC-Ext to Sparks

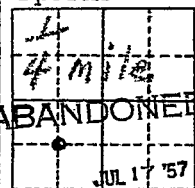

Log

to

No.

Sec.

T.

R.

Date Comm. 6-21-57 United Producing-DHM  
ring 8", TTD 1557 JUL 3 '57 8 5/8 1557/150  
W 3354 JUL 10 '57 W 4606 JUL 17 '57  
DST 5290-5320 L.H. 595' SW  
FP 65-300 BHP 1250

DGA