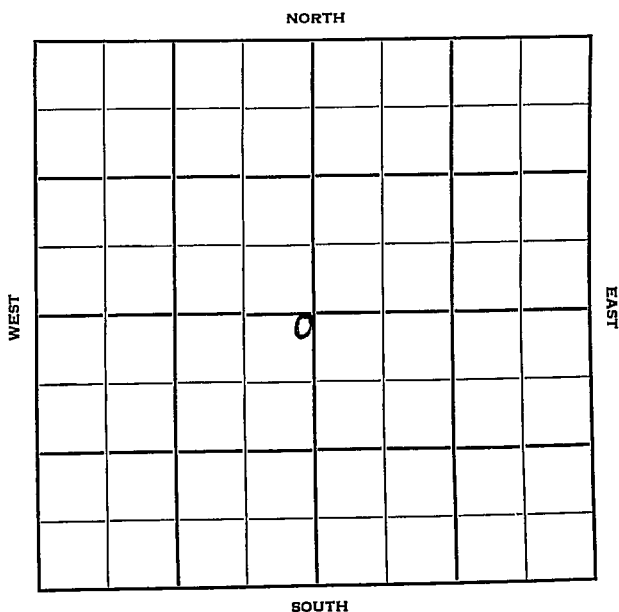


Section 9 Township 30 Range 33 WWell No. # 1 Allison Gas UnitCompany Stanolind

Sec. 9 Twp. 30 R. 33 W

Well No. # 1 Allison Gas Unit Farm

Stanolind Company

Contractor


150 Ft. from N. Line

Ft. from S. Line

150 Ft. from E. Line

Ft. from W. Line

NE NE SW

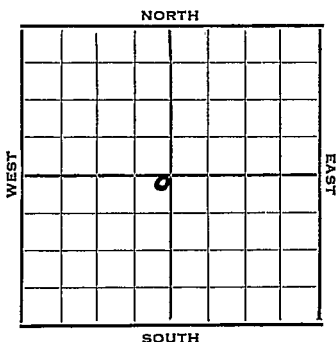

1952	Elev. 2967' GE REPORT
9/17	Location
9/24	"
10/1	"
10/8	"
10/15	8" @ 726'
10/22	RTD 2782' 5" @ 2777 Her 2641'
	Kriider 2682' Winfield 2722'
	Tow. 2776'
10/29	NR
11/5	DD 2792, 66/2649-62, 30/2667-72,
	48/2682-90, 66/2696-2712, 72/2722
	-34, 18/2734-40, 24/2744-48
11/12	Spud 10-9-52
	Gas Well
	TD 2792'
	8" @ 726
	Her. 2641, Kri 2682, Sin 2722,
	Tow. 2776
	TD 2782
	5" @ 2777
	DD 2792, 66/2649-62, 30/2667-72
	48/2682-90, 66/2696-2712, 72/
	2722-34, 18/2734-40, 24/2744-48
	17500A
	Comp. 10,448,000 gas

COMPLETED

County Haskell State KansasSec. 9 (Blk.) 30 (Sur.) S3W Map No.Operator StanolindWell No. 1 Farm Allison Gas UnitElev. 2967GL Location NE NE SW

150 Ft. From N Line SW150 Ft. From E Line QuarterIst. Report SEP 17 1952

Completion


Remarks

Spudding Date

Drlg. Data

Location

J. G. McGEHEE

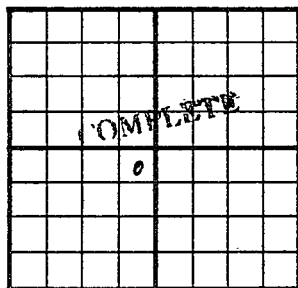County Haskell State KansasSec. 9 (Blk. Twp.) 30 (Sur. Rge.) 33W Map No.Operator StanolindWell No. 1 Farm Allison Gas UnitElev. 2967 Location NE NE SW150 Ft. From N Line SW150 Ft. From E Line Quarter

1st. Report

NOV 12 1952

Completion

Remarks

Spudding Date 10-9-52Drilg. Data Gas well TD 27928" @ 726 Her. 2641 Kri. 2682Win. 2722 Tow. 2776 TD 2782 5" @ 2777DD 2792 66/ 2649-62 30/ 2667-7248/ 2682-90 66/ 2696-2712 72/ 2722-3418/ 2734-40 24/ 2744-48 17500 AComp. 10,448,000 gas

J. G. McGEHEE