


DX 78-1

Haskell KANSAS

Section 9 Township 30 Range 32 W

Well No. # 1 Elliott Gas Unit "B"

Company Stanolind

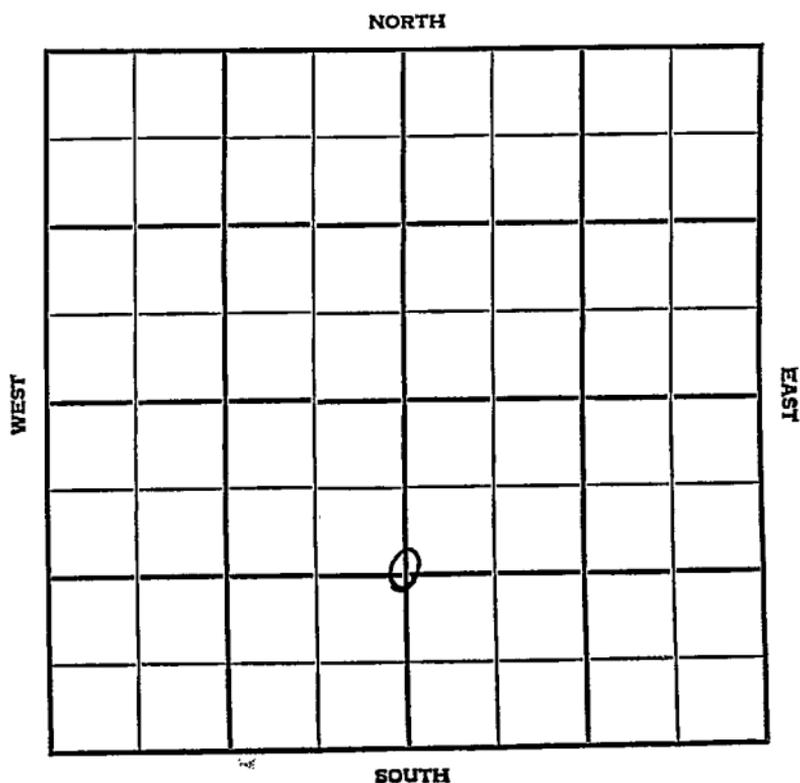

Haskell

KANSAS

SEC.	TWP.	R.
9	30	32 W

WELL NO.

1 Elliott Gas Unit "B"

FARM

COMPANY

Stanolind

CONTRACTOR

Barbour

Hugoton Pool

Ft. from N. Line


1320

Ft. from S. Line

2640

Ft. from E. Line

Ft. from W. Line

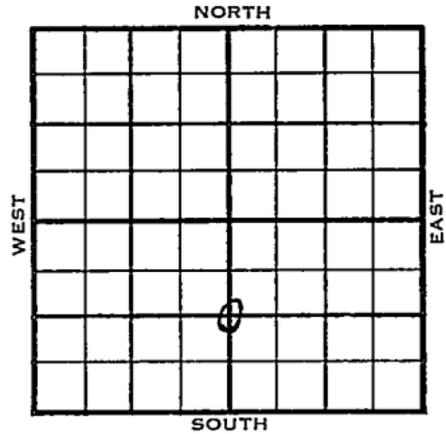C S $\frac{1}{2}$ Sec.

	ELEVATION	REPORT
1954	2896'	
12/15	Spud 12-7-54 8" @ 674 Her. 2654 Kri. 2706 Win. 2729 TD 2729 5" @ 2729	
1955 1/26	Spud 12-7-54 Gas well TD 2736 8" @ 674 Her. 2650 Kri. 2691 Win. 2733 TD 2729 5" @ 2729 CO to 2736 250 A frac. 500 A 232,000 CFG 14 GWPH 42/2706-13 24/2654-58 48/2660-68 24/2670-74 60/2694-2704 232,000 CFG 14 GWPH 7000 A 664,000 CFG 15 GWPH 8000 A 1,074,000 CFG 129 GWPH 781,000 CFG wtr. dec. to 34 GWPH TD 2736 Comp. 3,624,000 CFGPD 398#	

COMPLETED

County **Haskell** State **Kansas**

Sec. **9** (Blk. Twp.) **30** (Sur. Rge.) **3 2^W** Map No.

Operator **Stanolind**

Well No. **1** Farm **Elliott Gas Unit "B"**

Elev. **2896** Location **C S $\frac{1}{2}$ Sec.**



1320 Ft. From **S²** Line **Sec.**

2640 Ft. From **E** Line **Quarter**

Ist. Report **DEC 15 1954**

Completion

Remarks

Barbour - Contr.

Spudding Date **12-7-54**

Drlg. Data **Hugoton Pool**

8" @ 674 Her. 2654 Kri. 2706

Win. 2729 TD 2729 5" @ 2729

FADEN GILSTRAP

County Haske ll State Kansas

Sec. 9 (Blk. 30) (Sur. 32W) Map No.

Operator Stanolind

Well No. 1 Farm Elliott Gas Unit "B"

Elev. 2896 Location C S $\frac{1}{2}$ Sec.

COMPLETE

1320Ft. From S Line Sec.

2640Ft. From E Line Quarter

Ist. Report

Completion JAN 26 1955

Remarks Hugoton Pool

Barbour - Contr.

Spudding Date 12-7-54

Drig. Data Gas well TD 2736

8" @ 674 Her. 2650 Kri. 2691

Win. 2733 TD 2729 5" @ 2729

CO to 2736 250 A frac 500 A

232,000 cfg 14 gwph 42/ 2706-13

24/ 2654-58 48/ 2660-68 24/ 2670-74

60/ 2694-2704 232,000 cfg 14 gwph

7000 A 664,000 cfg 15 gwph 8000 A

1,074,000 cfg 129 gwph 781,000 cfg

wtr. dec. to 34 gwph TD 2736

Comp. 3,624,000 cfgpd 398#

FABEN GILSTRAP