


Map No. KANSAS Sec. 9 Twp. 30 R. 2^w
Well No. 5-B Latta Farm
Champlain Refg. Company

NORTH

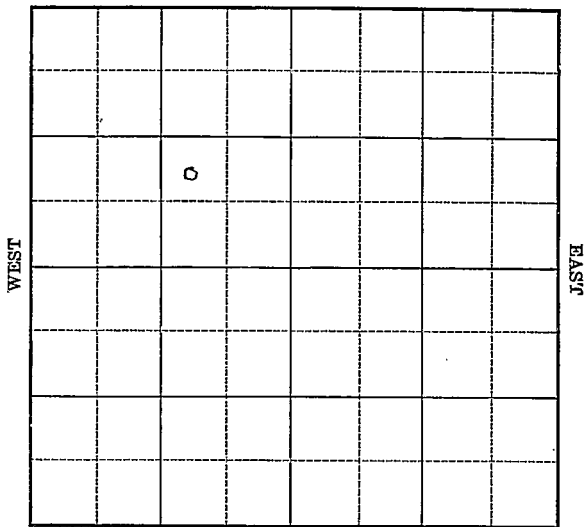

SOUTH

Location _____

Drilling Remarks _____

Rig Up _____

Drilling Remarks _____

RECORD

Cased _____ in. _____ ft.

Sand _____

Gas _____

Oil _____

Total Depth _____

PRODUCTION

1st 24 hrs. Nat. _____

1st 24 hrs. after shot _____

Gas _____ cu. ft.

Dry Hole _____

Abandoned _____


Map No. KANSAS Sec. 9 Twp. 30 R. 2 W
 Well No. 5-B Latta Farm
Champlain Refg. Company
NORTH

_____ Ft. from N. Line

990 Ft. from S. Line

990 Ft. from E. Line

_____ Ft. from W. Line

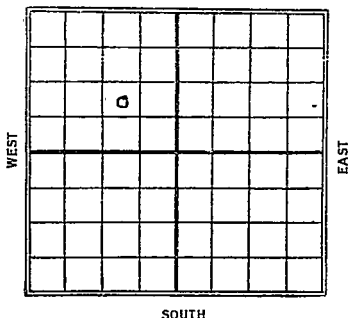

1928

Date	REPORT
9/19	Spud
9/26	Drly 300'
10/3	" 1315'
10/10	" 1875' 2032'
10/17	fighting cave 3020'
10/24	Drly 2075'
10/31	" 2207'
11/7	" 2330'
11/14	run 10" at 2330'
11/21	run 8" at 2395'
11/28	Drly 2585' H.F.W.
12/5	" 2615'
12/12	show of gas at 2792' to 2794' Drly
19/19	K.C.L. 3065' show of oil 3082 - TD. 3097 Still test
12/26	shot 30 gts - No test
1929	
1/2	Pump 30 bbls.
1/9	K.C. line 3065-82' TD. 3097 - shot 30 gts

MAP NO. KANSAS SEC. 9 TWP. 30 R. 2W

WELL NO. 5-B Latta

Champlain Ref. COMPANY

CONTRACTOR

SECTION PLAT

	0		

_____ FT. FROM N. LINE

990 FT. FROM S. LINE

990 FT. FROM E. LINE

_____ FT. FROM W. LINE

FIRST REPORTS

LOCATION _____

RIG UP _____

DRILLING AND REMARKS:

Spud

RECORD

CASED _____ IN. _____ FT.

SAND _____

GAS _____

OIL _____

TOTAL DEPTH _____

PRODUCTION

1ST 24 HRS. NAT. _____

1ST 24 HRS. AFTER SHOT _____

GAS _____ CU. FT.

DRY HOLE _____

ABANDONED _____

DATE

SEP 19 1928

S. J. LEWIS

192

SCOUT

KANSAS

Map No. _____ Sec. 9 Twp. 30 R. 2W

Well No. 5-B Satta

Champlain Ref. Company

Contractor

SECTION PLAT

_____ Ft. from N. Line

990 Ft. from S. Line

990 Ft. from E. Line

_____ Ft. from W. Line

	0		

COMPLETED

Location _____

Rig up _____

Drilling and Remarks: "

K.C.L. 3065-82

Blk 8-309 to

30 ft. jumper

RECORD

Cased _____ in., _____ ft.

Sand _____

Gas _____

Oil _____

Total Depth 3097

PRODUCTION

1st 24 hrs. Nat. _____

1st 24 hrs. after shot _____

Gas _____ Cu. Ft.

Dry Hole _____

Abandoned _____

Date

JAN 9 - 1929

S. J. LEWIS

Scout