


Map No. _____ Sec. 9 Twp. 30 R. 20
 Well No. 1 - East Latta "B" Farm
Champlain Ref. Company

NORTH

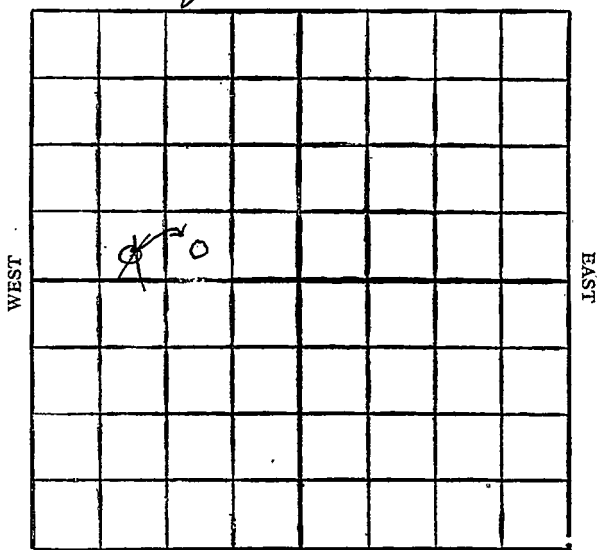

SOUTH

O. W. D. D

Location

Drilling Remarks

Rig Up

Drilling Remarks

RECORD

Cased in. ft.

Sand

Gas

Oil

Total Depth

PRODUCTION

1st 24 hrs. Nat.

1st 24 hrs. after shot

Gas cu. ft.

Dry Hole


Abandoned

Summer

Map No. Kansas Sec. 9 Twp. 30 R 2^wWell No. 1 East Latta "B" FarmChamplain Refg Company

NORTH

Ft. from N. Line

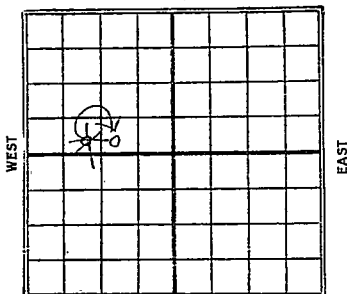330 Ft. from S. Line990 Ft. from E. Line~~990~~ Ft. from W. Line

SOUTH

Date 1927 REPORT O.W.D.D1/19 Rig bldg1/26 same2/22/9 Rigging up2/16 Spud2/23 Drlg 7503/2 " 8153/9 " 12003/16 " 16243/23 " 19173/30 Run 10" @ 19304/6 Gas sand 2020 to 35

10 to 12 m gas - water sand

2035-55 - Line 2055 - Drlg 2075

4/13 T.D. 2080 - U.R. 10"4/20 Drlg 21604/27 " 2380.5/4 " 25005/11 T.D. 2760 - 2 m gas - pulling 8" pipe - which has collapsed5/18 T.D. 2760 - Drlg up shoe5/251/1

- 6/8 - Kansas City line 3040 -
show heavy oil 3042 -
S.D. for orders -
- 6/9 - T.D. 3043 - Est 2 m gas -
spraying oil - about 6 bbls/hr.
- 6/10 - Drlg to 3046 - T.D. Est. @
80 bbls - per day -
- 6/15 - top K.C. line 3040 - show oil
3042 - T.D. 3052 - Swab 50 bbls.
- 6/22 - Shot 10 qts 3041-51 - mkg
1 bailer oil per hr.
- 6/29 - Steel line correction - pay 3046
to 3056 - shot 50 qts - swabbed
52 1/2 bbls - in 8 hrs.
- 7/13 - Top K.C. line 3046
T.D. 3056
shot 60 qts / 125 bbls
pumper

1935 O.W.D.D

6/26 Aug 6"

7/3 — 7/11 —

7/18 dly 3064

8/8 3130 W R 6"

8/15 3152 W R 6"

8/22 RO 3157-61
RO + W 3175-77
RO 3193-95
3196 T7 W R 6"

8/29 dly 3208

9/6 HF W 3236 S7 3255

9/12 T7 3255
No FF.

OVER

ABANDONED

O. W. D. D

1939

7/19

12 $\frac{1}{2}$ " - 30'

Fishing 900' #1B

Old #1 well plugged. now drlg.
in same hole for KC well.

8/3

Drlg. 3222'

8/10

Drlg. 3225'

8/17

" "

8/23

K. C. 3020'

7" - 3020'

T.D. 3225'

P. B. to 3056'

1000 acid.

15 bbls. oil.

COMPLETED

Map No. KAUSAS Sec. 9 Twp. 30 R. 2W

Well No. 1 East 8 Tatta

Chas. plain Ref. Company

Contractor

SECTION PLAT

0			

_____ Ft. from N. Line

330 Ft. from S. Line

_____ Ft. from E. Line

990 Ft. from W. Line

FIRST REPORTS

Location _____

Rig up _____

Drilling and Remarks:

Rig Bldg
Elevation
1324

RECORD

Cased _____ in., _____ ft.

Sand _____

Gas _____

Oil _____

Total Depth _____

PRODUCTION

1st 24 hrs. Nat. _____

1st 24 hrs. after shot _____

Gas _____ Cu. Ft.

Dry Hole _____

Abandoned _____

Date

JAN 19 1927

192

NOV 17 1927

S. J. LEWIS

Score

Reference

Care

Tracing

None

France Map

Scarborough Map

Moody Map

Scarborough Plat Book

Moody Plat Book

Sunrise
noisy
 Map No. KANSAS Sec. 9 Twp. 30 R. 2 W

Well No. 1 East & Latta

Champlain Ref. Company

Contractor

SECTION PLAT

_____ Ft. from N. Line

330 Ft. from S. Line

990 Ft. from E. Line

_____ Ft. from W. Line

Correction

Location _____

Rig up _____

Drilling and Remarks:

Reported this in
SE SW. NW.

should be

SW. SE NW.

RECORD

Cased _____ in., _____ ft.

Sand _____

Gas _____

Oil _____

Total Depth _____

PRODUCTION

1st 24 hrs. Nat. _____

1st 24-hrs. after shot _____

Gas _____ Cu. Ft.

Dry Hole _____

Abandoned _____

Date

FEB 23 1927

192

S. J. LEWIS

Scout

Returned	_____
Cards	_____ <i>LB</i>
Tracing	_____ <i>none</i>
France Map	_____
Scarborough Map	_____ <i>LB</i>
Moody Map	_____
Scarborough Plat Book	_____
Moody Plat Book	_____

Supper
No Maps
Map No. **KANSAS** Sec. **7** Twp. **20** R. **24**

Well No. **1 East & Latta**

Chaplain Ref. Company
Contractor

SECTION PLAT

Ft. from N. Line

230 Ft. from S. Line**990** Ft. from E. Line

Ft. from W. Line

COMPLETED

	0		

Location

RECORD

Cased _____ in., _____ ft.

Rig up

Sand _____

Drilling and Remarks:

Gas _____

Top H.C. line 3046

Oil _____

711 3056

Total Depth _____

Shot 609 to

PRODUCTION

125 ft.

1st 24 hrs. Nat. _____

pumper

1st 24 hrs. after shot _____

Gas _____ Cu. Ft.

Dry Hole _____

Abandoned _____

Date

JUL 13 1927**S. J. LEWIS Scout**

Returned.....

Cards.....

Tracing.....

France Map.....

Scarborough Map.....

Moody Map.....

Scarborough Plat Book.....

Moody Plat Book.....

MAP No. _____ SEC. 9 TWP. 30 S. R. 2 NWELL No. SaltsChampion

COMPANY

CONTRACTOR

on chert on
waiver

SECTION PLAT

_____ Ft. FROM N. LINE

_____ Ft. FROM S. LINE

_____ Ft. FROM E. LINE

_____ Ft. FROM W. LINE

LOCATION _____

RIG UP _____

DRILLING AND REMARKS:

3042-305650 gts100 lbs39.6 lb.

RECORD

CASED _____ IN. _____ FT.

SAND _____

GAS _____

OIL ☒TOTAL DEPTH 3056

PRODUCTION

1ST 24 HRS. NAT. _____

1ST 24 HRS. AFTER SHOT _____

GAS _____ CU. FT.

DRY HOLE _____

ABANDONED _____

DATE

Map No. 38 Sec. 9 Twp. 30 R. 2WWell No. 1 - East LattaChamplain Ref Company

Contractor

FIRST REPORTS

SECTION PLAT

Ft. from N. Line

330 Ft. from S. Line990 Ft. from E. Line

Ft. from W. Line

	0		

OWPD

Location

Rig up

Drilling and Remarks:

OTD 3057fig 6"

RECORD

Cased _____ in., _____ ft.

Sand _____

Gas _____

Oil _____

Total Depth _____

PRODUCTION

1st 24 hrs. Nat. _____

1st 24 hrs. after shot _____

Gas _____ Cu. Ft.

Dry Hole _____

Abandoned _____

Date

6-26-35 192

ORVAL MANNSCHRECK

Scout

Returned

Cards

Tracing

France Map

Scarborough Map

Moody Map

Scarborough Plat Book

Moody Plat Book

KANSAS

Map No. 38 Sec. 9 Twp. 30 R. 2WWell No. 1-East LattaChamplain Ref Company

Contractor

ABANDON

Ft. from N. Line

330 Ft. from S. Line990 Ft. from E. Line

Ft. from W. Line

SECTION PLAT

	0		

Location

Rig up

Drilling and Remarks:

D + FJ

RECORD

Cased in., ft.

Sand

Gas

Oil

Total Depth 3255

PRODUCTION

1st 24 hrs. Nat.

1st 24 hrs. after shot

Gas Cu. Ft.

Dry Hole


Abandoned

Date

ORVAL MANNSCHRECK

9-12-35 192

Scout

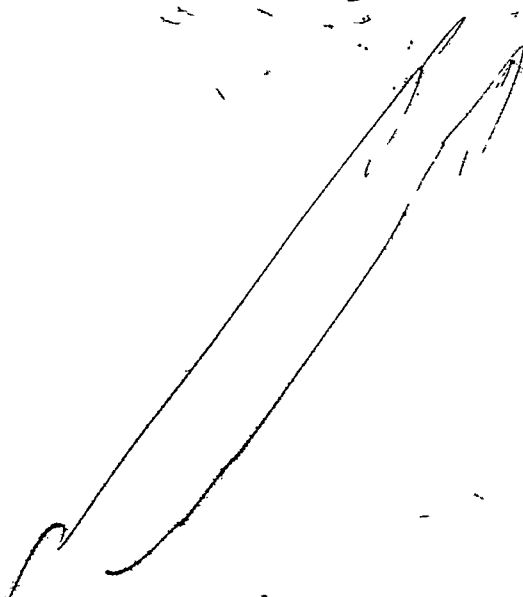

Returned	<i>RR</i>
Cards	<i>RR</i>
Tracing	<i>RR</i>
France Map	<i>X</i>
Scarborough Map	<i>X</i>
Moody Map	<i>X</i>
Scarborough Plat Book	<i>X</i>
Moody Plat Book	<i>X</i>

Map No. 38 Sec. 9 Twp. 30 R. 2WWell No. 1 Latta "B"Champlin

Company

Contractor

FIRST REPORT

C S $\frac{1}{2}$ SE NW Ft. from N. Line330 Ft. from S. Line990 Ft. from E. Line Ft. from W. Line

SECTION PLAT

LATTA POOL

Location Rig up

Drilling and Remarks:

12 $\frac{1}{2}$ " @ 30'Fishing 900' #1BOld #1 Well plugged
now drlg. in same
hole for KC Well

RECORD

Cased in., ft.Sand Gas Oil Total Depth

PRODUCTION

1st 24 hrs. Nat. 1st 24 hrs. after shot Gas Cu. Ft.Dry Hole Abandoned

Date

JUL 19 1939S. J. LEWIS Scout

Misc. Small Maps.....
Cards.....
Tracing.....
France Map.....
Scarborough Map.....
Moody Map.....
Geological Dept.
Moody Flat Book

KANSAS *Sumner*Map No. 38 Sec. 9 Twp. 30 R. 2WWell No. 1 Latta "B"Champion Company

Contractor

C 8 1/2 SE 1/4 NW
COMPLETED

SECTION PLAT

	0		

_____ Ft. from N. Line

330 Ft. from S. Line990 Ft. from E. Line

_____ Ft. from W. Line

Latta Pool

Location _____

Rig up _____

Drilling and Remarks:

KC 30207" @ 3020P.B. 30561000 @ adl15 8 1/2

RECORD

Cased _____ in., _____ ft.

Sand _____

Gas _____

Oil _____

Total Depth 3225

PRODUCTION

1st 24 hrs. Nat. _____

1st 24 hrs. after shot _____

Gas _____ Cu. Ft.

Dry Hole _____

Abandoned _____

Date

AUG 23 1939

19

S. J. LEWIS

Scout

Misc. Small Maps

Cards

Tracing

France Map

Scarborough Map

Moody Map

Geological Dept.

Moody Plat Book