


Section 9 Township 30 Range 2-WWell No. 6 LoveCompany Champlin

NORTH Latta Pool

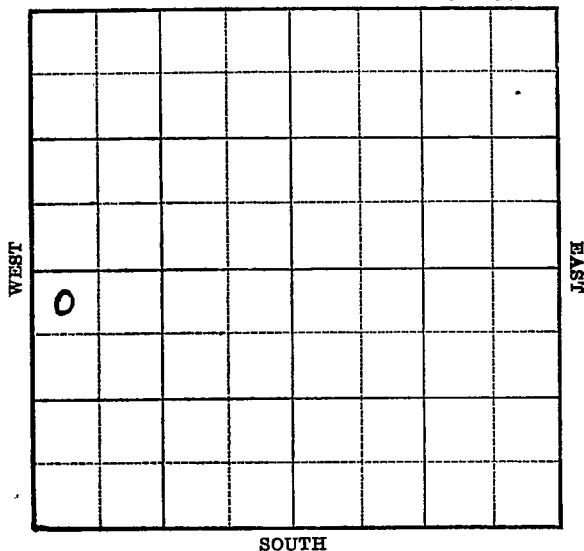

Map No. 38 Sec. 9 Twp. 30 R. 2WWell No. 6 Love.Champlin

Company

Contractor

FIRST REPORT

NW SW

330 Ft. from N. Line Ft. from S. Line Ft. from E. Line330 Ft. from W. Line**SECTION PLAT**

0			

LATTA POOL

Location Rig up

Drilling and Remarks:

12" - 41Dr1g. 1850**RECORD**Cased in., ft.Sand Gas Oil Total Depth **PRODUCTION**1st 24 hrs. Nat. 1st 24 hrs. after shot Gas Cu. Ft.Dry Hole Abandoned

Date

MAR 15 1939 19H. D. Hatfield Scout

Sumner **KANSAS**Map No. 38 Sec. 9 Twp. 20 R. 24Well No. 6. Love.Champlin Company

Contractor

COMPLETED380 Ft. from N. Line

_____ Ft. from S. Line

_____ Ft. from E. Line

380 Ft. from W. Line**SECTION PLAT**

0			

Let the Pool

Location _____

Rig up _____

Drilling and Remarks:

Running 30657" C 31642000 acidMinimum Well1588 1/2**RECORD**

Cased _____ in., _____ ft.

Sand _____

Gas _____

Oil _____

Total Depth 3167**PRODUCTION**

1st 24 hrs. Nat. _____

1st 24 hrs. after shot _____

Gas _____ Cu. Ft.

Dry Hole _____

Abandoned _____

Date

MAY 3 1939

19

S. J. LEWIS

Scout