


Section 9 ~~16~~ Township 30 Range 3W

Well No. 1 Leedy

Company Tom Palmer

Wildcat
NORTH

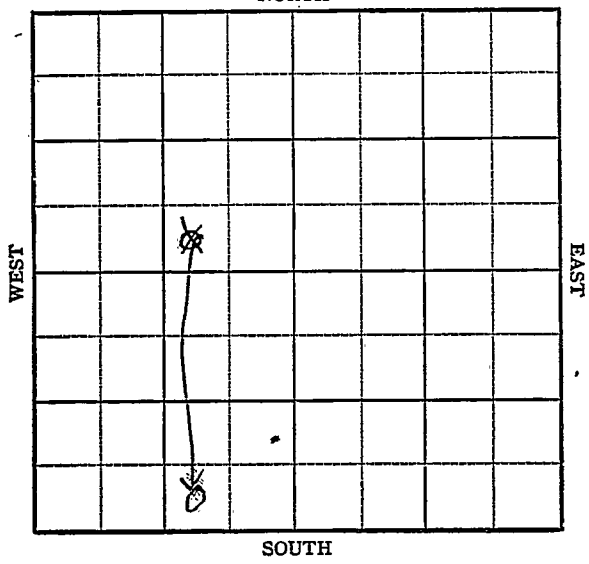

KANSAS

Summer



Sec. 16 Twp. 30 R. 3W

Well No. #1 Leedy Farm

Tom Palmer Company

Wildcat

 Ft. from N. Line


330'

 Ft. from S. Line

990' Ft. from E. Line

 Ft. from W. Line

SW SE ~~NW~~ SW

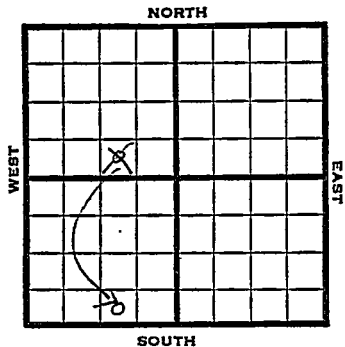

1948

Eli 1353'

REPORT

10/27

Drlg. 1200'

11/3

10" @ 127'

Drlg 2606'

11/10

KG 3234'

Drlg 3504'

11/16

Miss 3835'

Drlg. 3882'

11/23

TD 3911 In Miss

Miss 3835'

Aband.

ABANDONED

Map No. _____ Sec. 16 Twp. 30 R. 3W

Well No. 1 Leedy

Tom Palmer Company

FIRST REPORT Contractor

SW SE NW

SECTION PLAT

_____ Ft. from N. Line

330 Ft. from S. Line

990 Ft. from E. Line

_____ Ft. from W. Line

Summer County

Location _____

Rig up _____

Drilling and Remarks:

drlg. 1200

RECORD

Cased _____ in., _____ ft.

Sand _____

Gas _____

Oil _____

Total Depth _____

PRODUCTION

1st 24 hrs. Nat. _____

1st 24 hrs. after shot _____

Gas _____ Cu. Ft.

Dry Hole _____

Abandoned _____

Date

OCT 27 1948 19

S. J. LEWIS Scout

Map No. 38 Sec. 9 Twp. 30 R. 3W

Well No. .1 Leedy

Tom Palmer Company

ABANDONED

Contractor

SW SE SW

E. 1, 1353

SECTION PLAT

_____ Ft. from N. Line

330 Ft. from S. Line

990 Ft. from E. Line

_____ Ft. from W. Line

Summer County

Location _____

Rig up _____

Drilling and Remarks:

Miss 3 135

RECORD

Cased _____ in., _____ ft.

Sand _____

Gas _____

Oil _____

Total Depth 3911 in Miss

PRODUCTION

1st 24 hrs. Nat. _____

1st 24 hrs. after shot _____

Gas _____ Cu. Ft.

Dry Hole _____

Abandoned _____

Date

NOV 23 1948

19

S. J. LEWIS

Scout