
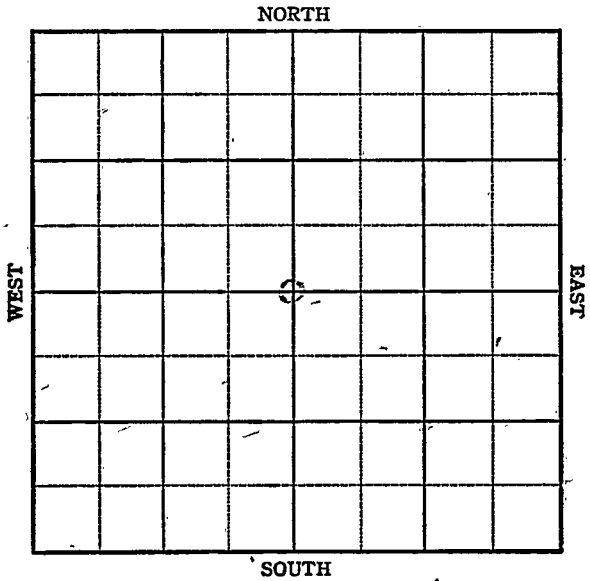


Section 9 Township 30 Range 38-WWell No. #1 MillsCompany Stanolind

KANSAS

Sec. 9 Twp. 30 R. 38-WWell No. #1 Mills FarmStanolind Company
Hugoton Pool2640 Ft. from N. Line Ft. from S. Line2640 Ft. from E. Line Ft. from W. Line

C. Sec

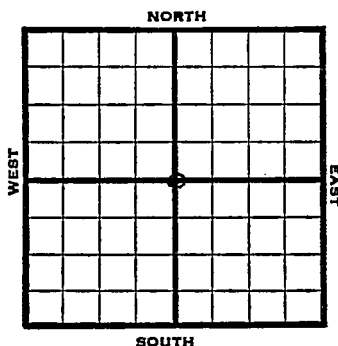

1947

Elev. 3150

REPORT

3/12

Location

3/18

8" @ 604'
WOC

3/25

5" @ 2586'
TD 2610'
RUST

4/2

TD 2625'
Plug 2568-168 shots 2534-63-4000
acid
Plug 2524-210 Shots 2465-2500-
2500 acid
Plug 2465-162 shots 2398-2445-80
6000acid

4/9

5" @ 2586'
Perf
25,000 Acid
5 M Gas
365# R Pr
TD 2610'

COMPLETED

KANSAS
KansasMap No. _____ Sec. 9 Twp. 30 R. 38WWell No. 1 Mills

Stanolind

Company

FIRST REPORT

Contractor

C Sec.


SECTION PLAT

2640 Ft. from N. Line

_____ Ft. from S. Line

2640 Ft. from E. Line

_____ Ft. from W. Line

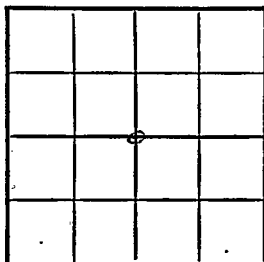

Grant County

Location X

Rig up _____

Drilling and Remarks:

RECORD

Cased _____ in., _____ ft.

Sand _____

Gas _____

Oil oil

Total Depth _____

PRODUCTION

1st 24 hrs. Nat. _____

1st 24 hrs. after shot _____

Gas _____ Cu. Ft.

Dry Hole _____

Abandoned _____

Date

MAR 12 1947

19

S. J. LEWIS

Scout

Map No. _____ Sec. 9 Twp. 30 R. 38W

Well No. 1 Mills

Stanolind Company

COMPLETE

Contractor

C Sec.


E13150
SECTION PLAT

2640 Ft. from N. Line

_____ Ft. from S. Line

2640 Ft. from E. Line

_____ Ft. from W. Line

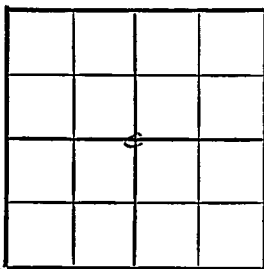

Grant County

Location _____

Rig up _____

Drilling and Remarks:

5' C2586

Prof.

2500 acid

4M Gas

365# R/A

RECORD

Cased _____ in., _____ ft.

Sand _____

Gas _____

Oil _____

Total Depth 2610

PRODUCTION

1st 24 hrs. Nat. _____

1st 24 hrs. after shot _____

Gas _____ Cu. Ft.

Dry Hole _____

Abandoned _____

Date

APR 9 1947 19 S. J. LEWIS Scout