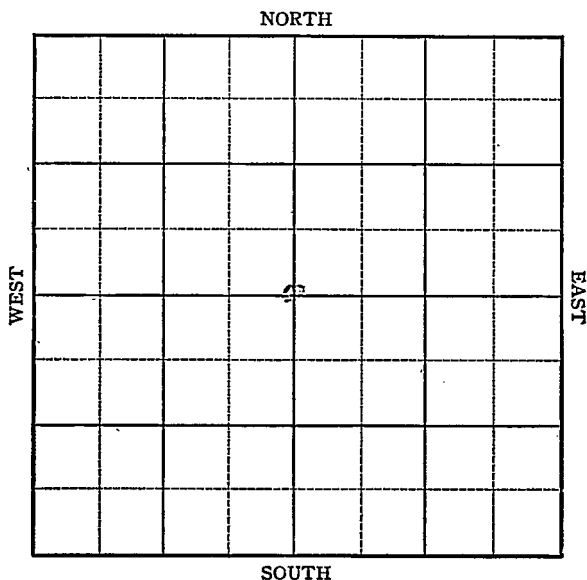


KANSAS

Stanton County

FORM 51 5M 6-46 PETROL

Section 9 Township 30 Range 39-WWell No. #1 Baughman "B"Company Stanoline

KANSAS

Stanton County ✓


Sec. 9 Twp. 30 R. 39WWell No. #1 Baughman "B" Farm

Stanolind

Hugoton Company

2640 Ft. from N. Line Ft. from S. Line2640 Ft. from E. Line Ft. from W. Line

C Sec.

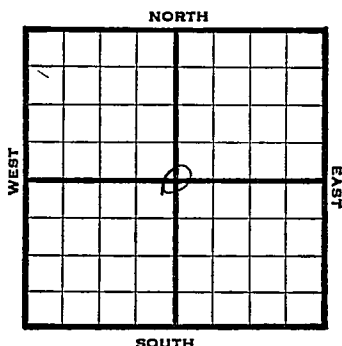

1946 REPORT

Elev. 3201'

8/21 Drlg. 245'

8/27 8" @ 597
Drlg 2025'9/5 5" @ 2497
TD 2533'
RUST9/10 588 shots 2320-2479
21000 acid

9/18 " " "

9/24 " " "

10/2 5" @ 2497'
Perf
30,000 Acid
2,700,000 Gas
TD 2533'
RPR 397#

COMPLETED

KANSAS Pool Name Hugoton
 Map No. _____ Sec. 9 Twp. 30 R. 39W
 Well No. 1 Baughman

Stanolind Company

FIRST REPORT

Contractor _____

C Sec.


SECTION PLAT

2640 Ft. from N. Line

_____ Ft. from S. Line

2640 Ft. from E. Line

_____ Ft. from W. Line

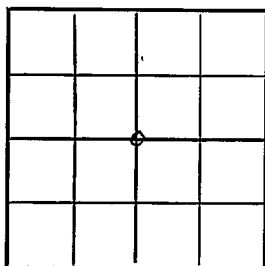

Stanton County

Location _____

Rig up _____

Drilling and Remarks:

drlg. 245'

RECORD

Cased _____ in., _____ ft.

Sand _____

Gas _____

Oil _____

Total Depth _____

PRODUCTION

1st 24 hrs. Nat. _____

1st 24 hrs. after shot _____

Gas _____ Cu. Ft.

Dry Hole _____

Abandoned _____

Date

AUG 21 1946 19 _____ S. J. LEWIS Scout

Kansas

Pool Name HugotonMap No. _____ Sec. 9 Twp. 30 R. 39WWell No. 1 Baughman "B"Stanolind


Company

CORRECTION

Contractor

C Sec.

SECTION PLAT

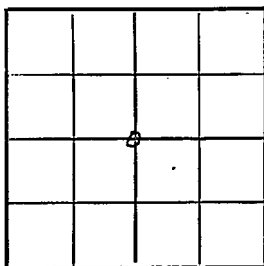2640 Ft. from N. Line Ft. from S. Line2640 Ft. from E. Line Ft. from W. LineStanton County

Location _____

Rig up _____

Drilling and Remarks:

Reported as

#1 Baughman

RECORD

Cased _____ in., _____ ft.

Sand _____

Gas _____

Oil _____

Total Depth _____

PRODUCTION

1st 24 hrs. Nat. _____

1st 24 hrs. after shot _____

Gas _____ Cu. Ft.

Dry Hole _____

Abandoned _____

Date _____

SEP 5 1946 19

S. J. LEWIS

Scout

KANSAS Kansas Pool Name Hugoton PoolMap No. _____ Sec. 9 Twp. 30 R. 39WWell No. 1 Baughman "B"Stanolind Company**COMPLETED**

Contractor


C Sec.

E1,320/
SECTION PLAT2640 Ft. from N. Line

_____ Ft. from S. Line

2640 Ft. from E. Line

_____ Ft. from W. Line

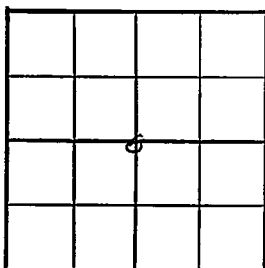Stanton County

Location _____

Rig up _____

Drilling and Remarks:

5102499Prof30000 acid2,700,000 Gas397th Rth**RECORD**

Cased _____ in., _____ ft.

Sand _____

Gas _____

Oil _____

Total Depth 2589**PRODUCTION**

1st 24 hrs. Nat. _____

1st 24 hrs. after shot _____

Gas _____ Cu. Ft.

Dry Hole _____

Abandoned _____

Date

OCT 2 1946 19S. J. LEWIS Scout