


34-31-1W

WELL LOG BUREAU—KANSAS GEOLOGICAL SOCIETY
508 East Murdock, Wichita, Kansas

Company. ALADDIN PETROLEUM CORPORATION
Farm- Droll No. 1

SEC. 34 T. 31 R. 1W
NW NW NW

Total Depth. 4193
Comm. 2-23-55 Comp. 3-17-55
Shot or Treated.
Contractor. Crowe Drilg. Co., Inc.
Issued. 4-23-55

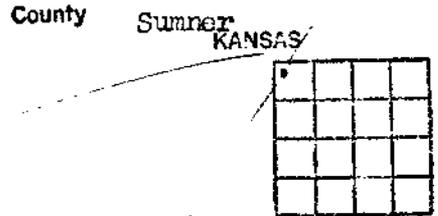

CASING:

8 5/8" 324' com. w/275 sx

Elevation. 1274

Production. dry

Figures indicate Bottom of Formations.

clay, shale & lime	260
shale & lime	1340
shale & sdy lime	1425
lime & shale	2235
lime & shale brks	2330
lime & shale	2915
shale, lime & shells	3030
shale	3036
Kansas City lime	3150
lime	3215
lime & shale brks	3325
lime & shale	3535
shale, lime & shells	3655
shale & lime	3662
Miss. chat	3680
Miss. lime	4015
lime & shale	4070
Simpson shale	4110
Simpson sand	4122
sand, shale & lime	4193
Arbuckle	4193
Total depth	
(Deduct 2' from above to equal D.F. Measure)	
Scout Tops:	
Kansas City	3039
Mississippi	3660
Simpson sand	4112
Arbuckle	4183