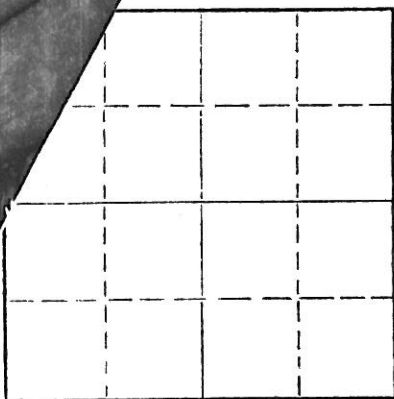


WELL PLUGGING RECORD

NORTH

Locate well correctly on above
Section Plat

Sumner

County. Sec. 22 Twp. 31S Rge. 1 (E) 1 (W)

Location as "NE/CNW/SW" or footage from lines 330' E/L, 330' S/L SE/4

Lease Owner Aladdin Petroleum Corporation

Lease Name Heskett

Well No. 1

Office Address 809 Petroleum Building

Character of Well (completed as Oil, Gas or Dry Hole) Oil

Date well completed August 25, 1955

Application for plugging filed Sept. 5, 1963

Application for plugging approved Sept. 6, 1963

Plugging commenced Sept. 15, 1963

Plugging completed Sept. 19, 1963

Reason for abandonment of well or producing formation not profitable

If a producing well is abandoned, date of last production September 1963

Was permission obtained from the Conservation Division or its agents before plugging was commenced? yes

Name of Conservation Agent who supervised plugging of this well Howard Hess

Producing formation Depth to top Bottom Total Depth of Well 3715 Feet

Show depth and thickness of all water, oil and gas formations.

OIL, GAS OR WATER RECORDS

CASING RECORD

FORMATION	CONTENT	FROM	TO	SIZE	RUT IN	PULLED OUT
				8-5/8	358'	None
				5-1/2	3715	2633'

Describe in detail the manner in which the well was plugged, indicating where the mud fluid was placed and the method or methods used in introducing it into the hole. If cement or other plugs were used, state the character of same and depth placed, from feet to feet for each plug set.

Plug 3 sacks cement @ 3130'.

Mud to 320'

Rock Bridge 320' to 300'

Filled w/4 yards ready-mix cement from 300' to base of cellar.

RECEIVED
STATE CORPORATION COMMISSION

OCT 8 1963

CONSERVATION DIVISION
Wichita, Kansas

(If additional description is necessary, use BACK of this sheet)

Name of Plugging Contractor

Glenn & Smith Pipe Pulling Co.

Address

Box 156 Ellinwood, Kansas

STATE OF KANSAS, COUNTY OF SEDGWICK, ss.

Jerome M. Johnson (employee of owner) of the above-described well, being first duly sworn on oath, says: That I have knowledge of the facts, statements, and matters herein contained and the log of the above-described well as filed and that the same are true and correct. So help me God.

(Signature)

J. M. Johnson

809 Petroleum Building
(Address)

SUBSCRIBED AND SWORN TO before me this 1st day of October, 1963

My commission expires November 1, 1965

Faye English

Notary Public.