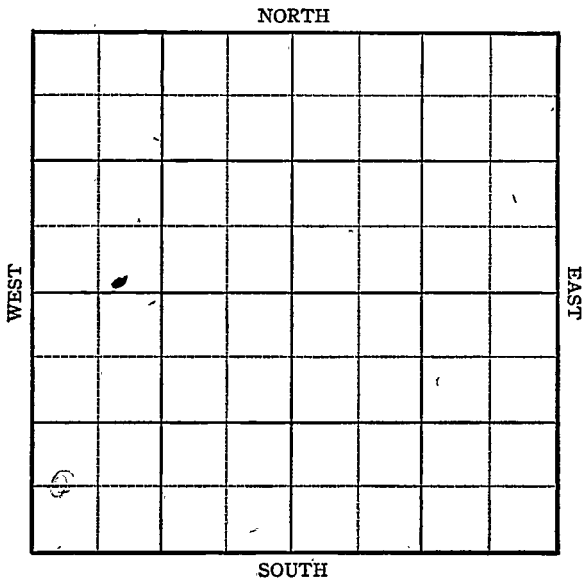


## KANSAS Barber

FORM 51 5M PETROL


Section 1 Township 31 Range 14WWell No. 1 P. LakeCompany Driller Gas

Sec. 1 Twp. 31 R. 14-W

Well No. #1 P. Lake Farm

Driller Gas Company

         Ft. from N. Line  
660 Ft. from S. Line  
         Ft. from E. Line  
330 Ft. from W. Line

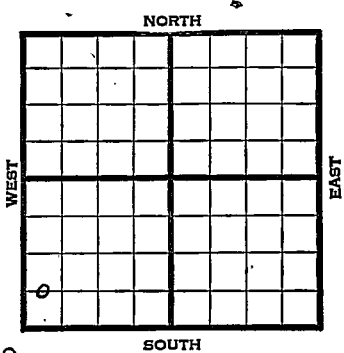

C W L SW SW Elev. 1700

| REPORT |                  |
|--------|------------------|
| 1945   |                  |
| 8/22   | Derrick          |
| 8/29   | Anhy. 625        |
|        | Drlg. 660        |
| 9/5    | 10" @ 688        |
|        | Drlg. 2218       |
| 9/12   | Douglas 3787     |
|        | Lans 3823        |
|        | Drlg. 3150       |
| 9/19   | Massey zone 4255 |
|        | Miss. 4322       |
|        | TD 4402          |
|        | 7" @ 4401 RUST   |
| 9/26   | " " "            |
| 10/3   | " " "            |
| 10/10  | 1000 acid.       |
| 10/17  | " "              |
| 10/24  | " "              |
| 10/31  | " " "            |
| 11.7   | Viola 4400       |
|        | 7" @ 4401        |
|        | 1000 acid.       |
|        | TD 4409          |
|        | 5 M Gas          |

COMPLETED

- KANSAS  
Kansas

Pool Name

Skinner

Map No. 93 Sec. 1 Twp. 31 R. 14 WWell No. 1 P. Lake

Driller Gas


Company

## FIRST REPORT

Contractor

C W.L SW SW

## SECTION PLAT

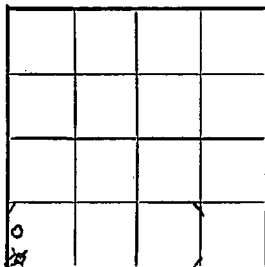         Ft. from N. Line660 Ft. from S. Line         Ft. from E. Line330 Ft. from W. Line

Barber County

Location                                 Rig up                                 

Drilling and Remarks:

derrick

## RECORD

Cased                  in.,                  ft.Sand                                 Gas                                 Oil                                 Total Depth                                 

## PRODUCTION

1st 24 hrs. Nat.                                 1st 24 hrs. after shot                                 Gas                                  Cu. Ft.Dry Hole                                 Abandoned                                 

Date

AUG 22 1945

19

S. J. LEWIS

Scout

KANSAS

Kansas

Pool Name SkinnerMap No. 93 Sec. 1 Twp. 31 R. 14WWell No. 1 P. Lake

Driller's Gas

Company

COMPLETED

Contractor

C W L SW SW

R 1,1700  
SECTION PLAT

Ft. from N. Line

660

Ft. from S. Line

Ft. from E. Line

330

Ft. from W. Line

|   |  |  |  |
|---|--|--|--|
|   |  |  |  |
|   |  |  |  |
|   |  |  |  |
| 0 |  |  |  |

Barber County

Location

Rig up

Drilling and Remarks:

Wife 44007" C 44011000 acid5 M Gas

## RECORD

Cased \_\_\_\_\_ in., \_\_\_\_\_ ft.

Sand \_\_\_\_\_

Gas \_\_\_\_\_

Oil \_\_\_\_\_

Total Depth 4402

## PRODUCTION

1st 24 hrs. Nat. \_\_\_\_\_

1st 24 hrs. after shot \_\_\_\_\_

Gas \_\_\_\_\_ Cu. Ft.

Dry Hole \_\_\_\_\_

Abandoned \_\_\_\_\_

Date

NOV 7 1945 19

S. J. LEWIS

Scout