


Section 1 Township 31 Range 14-W

Well No. #3 Marjorie

Company Phillips

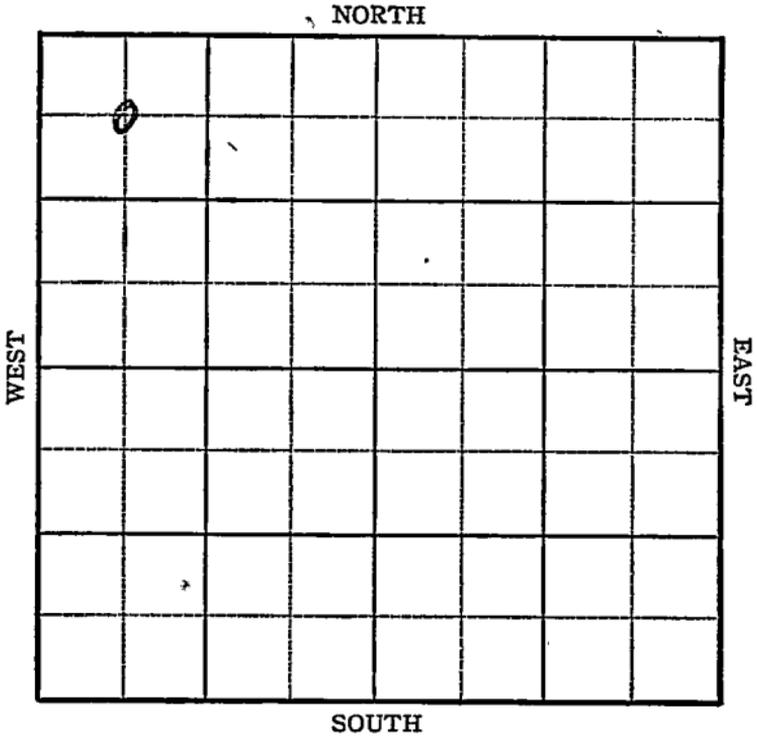

KANSAS

Barber County

Sec. 1 Twp. 31 R. 14W

Well No. #3 Marjorie Farm _____

Phillips Company


Marjorie

660 Ft. from N. Line

_____ Ft. from S. Line

_____ Ft. from E. Line

660 Ft. from W. Line

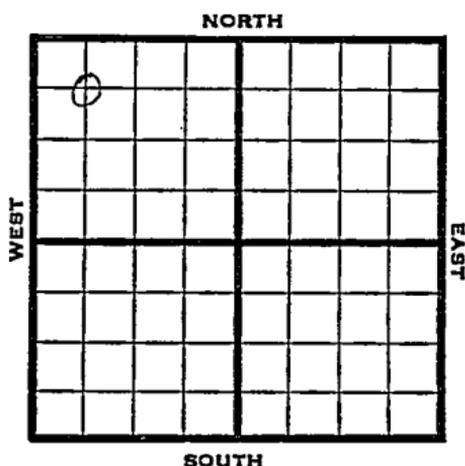

C NW NW

1946 Elev. 1705 REPORT

- 2/27 Anhy. 639
8" @ 811
1148'
- 3/7 Drlg. 2919'
- 3/14 Drlg. 3807'
- 3/21 Viola 4422-30' T.D.
- 3/28 5" - 4427' 24 shots 4413-21'
500 acid.
- 4/4 33 shots 4400-4405
500 acid. Water
12 shots 4400-4406 W.
PB 4408
- 4/10 PB 4411
- 4/16 " "
- 4/24 Viola 4422
5" @ 4427
TD 4430

ABANDONED

Kansas Pool Name Marjorie
 KANSAS
 Map No. 23 Sec. 1 Twp. 31 R. 14W
 Well No. 3 Marjorie

Phillips Company

FIRST REPORT Contractor

C NW NW

SECTION PLAT

660 Ft. from N. Line
 _____ Ft. from S. Line
 _____ Ft. from E. Line
660 Ft. from W. Line

D			

Barber County

Location _____

Rig up _____

Drilling and Remarks:
 anhy 639
 8"-811
 1148'

RECORD

Cased _____ in., _____ ft.
 Sand _____
 Gas _____
 Oil _____
 Total Depth _____

PRODUCTION

1st 24 hrs. Nat. _____
 1st 24 hrs. after shot _____
 Gas _____ Cu. Ft.
 Dry Hole _____
 Abandoned _____

Date

FEB 27 1946 19

S. J. LEWIS Scout

