
FORM 51 25M 8-50 WESTERN Stevens

KANSAS

Section 1 Township 31 Range 38W

Well No. #1-1 Mason

Company Hugoton Prod.

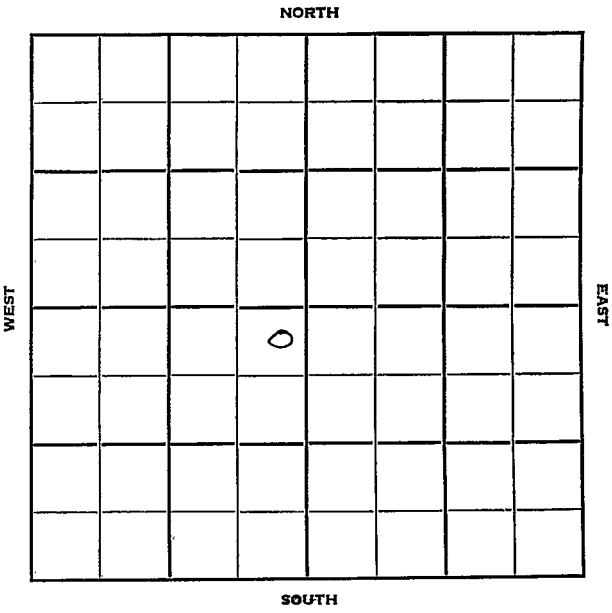

FORM 252-B
10M 8-51 TPCO.

Stevens KANSAS ✓

Sec. 1 Twp. 31 R. 38W

Well No. 1-1 Mason Farm

Hugoton Prod. Company

Contractor


200' Ft. from N. Line

Ft. from S. Line

200' Ft. from E. Line

Ft. from W. Line

NE NE SW

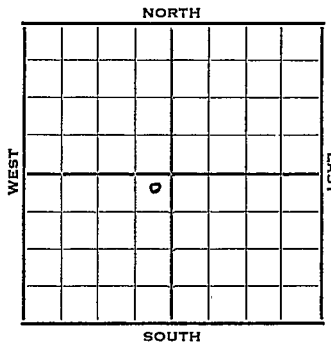

1952	Elev. 3091' REPORT
4/30	Location
5/7	"
5/14	"
5/21	MI
5/28	10" @ 520 Drlg. 2120'
6/11	RTD 2427' 7" @ 2415' DD 2670 TD 2000 A
6/18	NR
6/25	Hol 2378 Her 2418 Up Krider 2432 Win 2511 Up Ft 2579 Low Ft 2630
7/2	NR
7/9	NR
7/17	NR
7/23	Spud 5-20-52 Gas Well TD 2670' 10" @ 520' 7" @ 2415' TD 2670 Hol 2378 Hr. 2418 Kri 2432 Win 2511 Ft Riley 2579 22000 A Comp. 21,800,000 gas 395#

COMPLETED

FORM 275 FOR SALE BY KANSAS BLUE PRINT CO.


County Stevens State Kansas

Sec. 1 (Blk. Twp.) 31 (Sur. Rge.) 38W Map No.

Operator Hugoton Prod.

Well No. 1-1 Farm Mason

Elev. Location NE NE SW

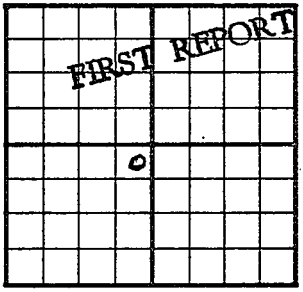

200 Ft. From N Line SW

200 Ft. From E Line Quarter

1st. Report APR 30 1952

Completion

Remarks

Spudding Date

Drlg. Data

Location

J. G. McGEHEE

FORM 275 FOR SALE BY KANSAS BLUE PRINT CO


County Stevens State Kansas

Sec. 1 (Blk. / Twp.) 31 (Sur. / Rge.) 38W Map No.

Operator Hugoton Prod.

Well No. 1-1 Farm Mason

Elev. 3091 Location NE NE SW

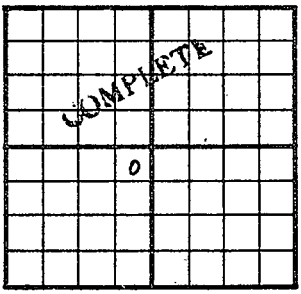

200 Ft. From N Line SW

200 Ft. From E Line Quarter

1st. Report

Completion JUL 2 3 1952

Remarks

Spudding Date 5-20-52

Drlg. Data Gas well TD 2670

10" @ 520 7" @ 2415 TD 2670

Hol. 2378 Her. 2418 Kri. 2432

Win. 2511 Ft. Riley 2579 22000 A

Comp. 21,800,000 gas 395#

J. G. McGEHEE