

Sec. 1 Twp. 31 R. 36W ✓

Well No. 1 Seybold Farm

Magnolia Company

Hugoton Pool


330 Ft. from N. Line

 Ft. from S. Line

 Ft. from E. Line

330 Ft. from W. Line

NW SE

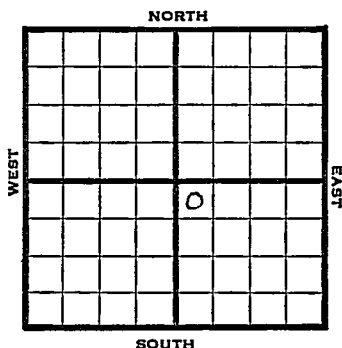

1948 Elev. 3020' REPORT

9/1 Location

9/8 10" @ 695' "
Drlg. 708'

9/14 Drlg. 2895'

9/21 7" @ 2802' "
TD 2803'

9/29 192 shots 2720-58 7000 acid
96 " 2666-88 2000 "
48 " 2657-60 6000 "
44 " 2610-44 7000 "

10/6 "

10/13 7" @ 2802' "
Perf.
Acid 29,000
Gas 18,900,000
R. Pr. 390#
TD 2803'

COMPLETED

Map No. _____ Sec. 1 Twp. 31 R. 36W

Well No. 1 Seybold

Magnolia Company

COMPLETE

Contractor

NW SE

E 113020
SECTION PLAT

330 Ft. from N. Line

_____ Ft. from S. Line

_____ Ft. from E. Line

330 Ft. from W. Line

		0	

Stevens County

Location _____

Rig up _____

Drilling and Remarks:

7" C 2802

Perf
2960000000

18,900,000 lbs

RECORD

Cased _____ in., _____ ft.

Sand _____

Gas _____

Oil _____

Total Depth 2802

PRODUCTION

1st 24 hrs. Nat. _____

1st 24 hrs. after shot _____

Gas _____ Cu. Ft.

Dry Hole _____

Abandoned _____

Date

OCT 13 1948

19

S. J. LEWIS

Scout