


Section 1 Township 31 Range 34 W

Well No. #1 Sneed

Company Cities Service

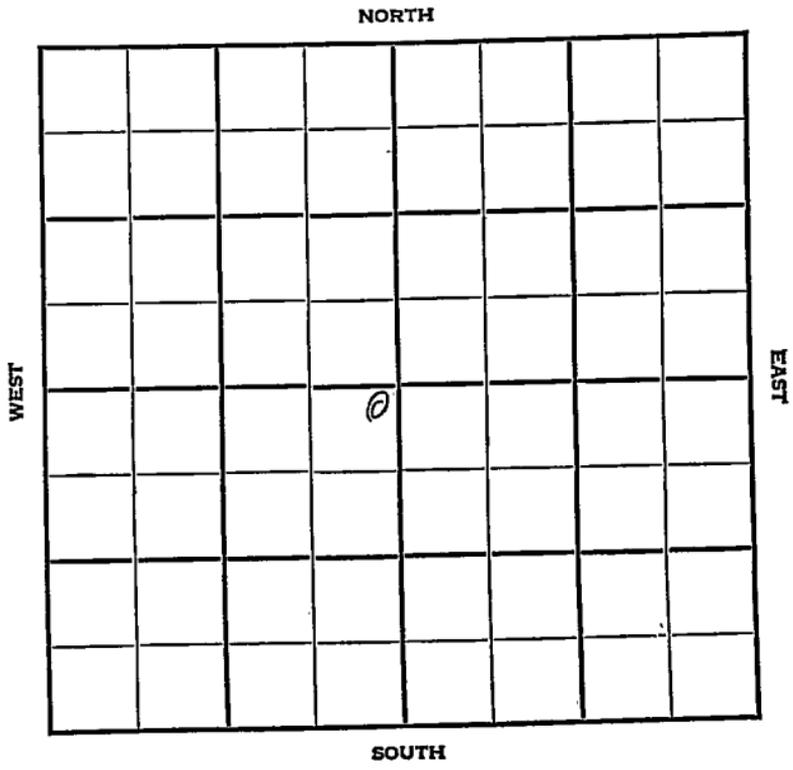

KANSAS

Seward



Sec. 1 Twp. 31 R. 34W

Well No. #1 Sneed Farm

Cities Service Company

Hugoton Pool


100' Ft. from N. Line

\_\_\_\_\_ Ft. from S. Line

100' Ft. from E. Line

\_\_\_\_\_ Ft. from W. Line

NE SW

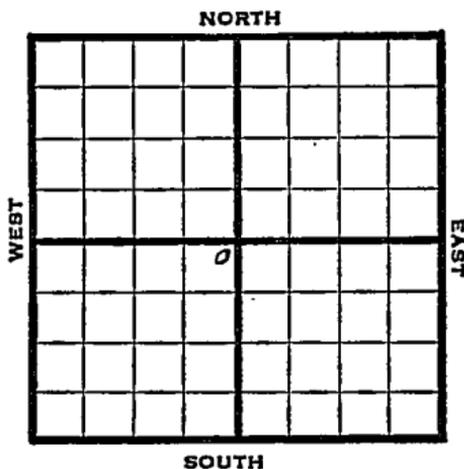

1948

E<sub>1</sub> 2940'

REPORT

- 6/16 Location
- 6/23 "
- 6/29 "
- 7/8 RUR
- 7/14 8" @ 640'  
Drlg 2180'
- 7/21 TD 2791'  
5" @ 2790'
- 7/28 "
- 8/4 "
- 8/11 200 shots 2730-70 11000 acid  
120 shots 2684-2708  
150 shots 2642-72  
50 shots 2622-32  
70 shots 2586-2600 23500 acid
- 8/18 " "
- 8/25 5" @ 2790'  
TD 2791'  
Perf 34,500 acid  
24,700,000 gas  
425# /R. Pr.  
Comp

**COMPLETED**

Map No. \_\_\_\_\_ Sec. 1 Twp. 31 R. 34W

Well No. 1 Sneed

Cities Service Company

**FIRST REPORT** Contractor \_\_\_\_\_

NE SW

100 Ft. from N. Line

\_\_\_\_\_ Ft. from S. Line

100 Ft. from E. Line

\_\_\_\_\_ Ft. from W. Line

SECTION PLAT

	o		

Seward County

Location X

Rig up \_\_\_\_\_

Drilling and Remarks:

RECORD

Cased \_\_\_\_\_ in., \_\_\_\_\_ ft.

Sand \_\_\_\_\_

Gas \_\_\_\_\_

Oil \_\_\_\_\_

Total Depth \_\_\_\_\_

PRODUCTION

1st 24 hrs. Nat. \_\_\_\_\_

1st 24 hrs. after shot \_\_\_\_\_

Gas \_\_\_\_\_ Cu. Ft.

Dry Hole \_\_\_\_\_

Abandoned \_\_\_\_\_

Date

JUN 1 6 1948 19 \_\_\_\_\_ S. J. LEWIS Scout

Seward County Kansas State

Map No. \_\_\_\_\_ Sec. 1 Twp. 31 R. 34W

Well No. 1 Sneed

Cities Service Company

**COMPLETE**

Contractor

NE SW

*E 1,2940*  
SECTION PLAT

100 Ft. from N. Line

\_\_\_\_\_ Ft. from S. Line

100 Ft. from E. Line

\_\_\_\_\_ Ft. from W. Line


Hugoton Pool

Remarks:

*5' 62790*

*AD 2791*

*Perf*

*84,500 acid*

*24,700,000 Gas*

*425 R/B*

Date  
AUG 25 1948

Scout  
S. J. LEWIS