
DX 78-1

Seward KANSAS

Section 1 Township 31 Range 32W

Well No. 1 J. R. Blythe

Company Skelly Oil

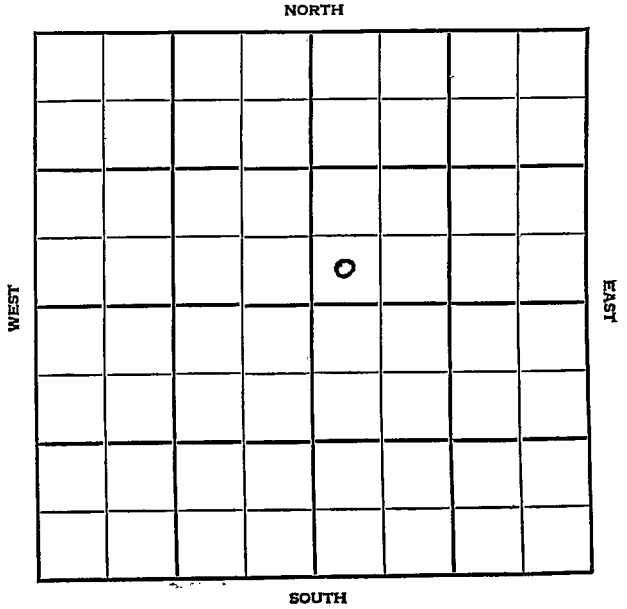

Wes Seward KANSAS

SEC.	TWP.	R.
1	31	32 W

WELL NO.

1 J. R. Blythe FARM
COMPANY

Skelly Oil
CONTRACTOR


_____ Ft. from N. Line

330 Ft. from S. Line

_____ Ft. from E. Line

330 Ft. from W. Line

SW SW NE

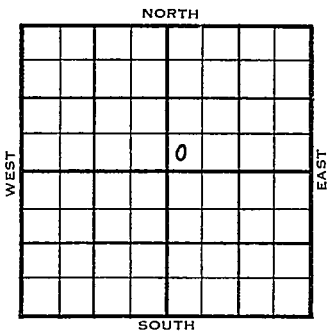

	ELEVATION	REPORT
1954	2832'	
4/27		Spud 4-22-54 10" @ 702 WOC
5/5		Hol 2557', Her. 2612', RTD 2620' 7" @2612'
6/15		Spud 4-22-54 Gas well TD 2720 10" @ 702 Hol. 2557 Her. 2612 TD 2620 7" @ 2612 Kr. 2665 A-frac. DD 2720 20 BWPH PB 2694 6000 A 560,000 CFG 4 BWPH 325# 4000 A 850,000 gas 30 GWPH Comp. 2,720,000 CFGPD

COMPLETED

DX-78

FORM 275 FOR SALE BY KANSAS BLUE PRINT CO.


County Seward State Kansas

Sec. 1 (Blk. / Twp.) 31 (Sur. / Rge.) 32W Map No.

Operator Skelly Oil

Well No. 1 Farm J. R. Blythe

Elev. Location SW SW NE

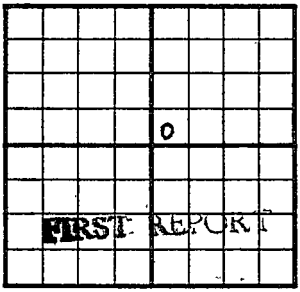

330 Ft. From S Line NE

330 Ft. From W Line Quarter

1st. Report APR 27 1954

Completion

Remarks

Spudding Date 4-22-54

Drlg. Data

10" @ 702 WOC

J. G. McGEHEE

FORM 275 FOR SALE BY KANSAS BLUE PRINT CO.


County Seward State Kansas

Sec. 1 (Blk. Twp.) 31 (Sur. Rge.) 3 2W Map No.

Operator Skelly Oil

Well No. 1 Farm J. R. Blythe

Elev. 2832 Location SW SW NE

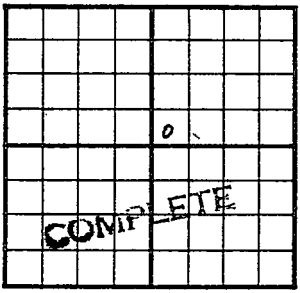

330 Ft. From S Line NE

330 Ft. From W Line Quarter

1st. Report

Completion JUN 15 1954

Remarks

Spudding Date 4-22-54

Drlg. Data Gas well TD 2720

10" @ 702 Hol. 2557 Her. 2612

TD 2620 7" @ 2612 Kr. 2665 A-frac

DD 2720 20 bwph PB 2694 6000 A

560,000 cfg 4 bwph 325# 4000 A

850,000 gas 30 gwph

Comp. 2,720,000 cfgpd

J. G. McGEHEE