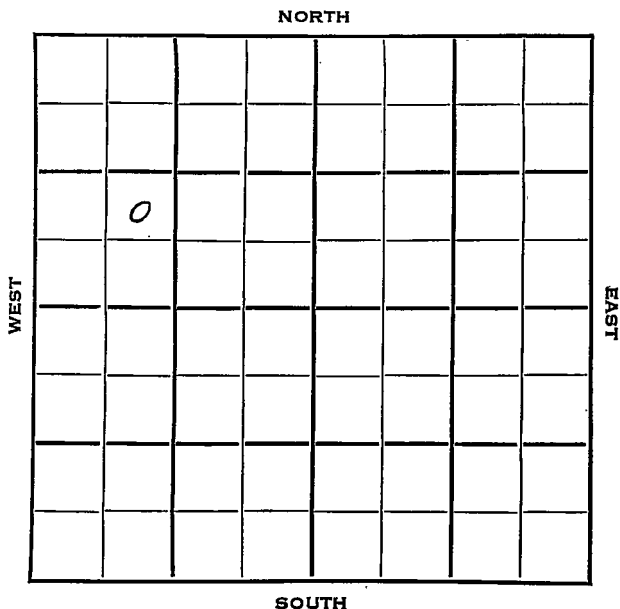


KANSASSection 1 Township 31 Range 2WWell No. 1 - IngramCompany J.P. Gatty et al

Sumner

KANSAS ✓

Sec. 1 Twp. 31 R. 2WWell No. #1 Ingram FarmJ. P. Gatty et al CompanyH. M. Williams Contractor

Wildcat


Ft. from N. Line

990 Ft. from S. Line

Ft. from E. Line

990 Ft. from W. Line

NE SW NW

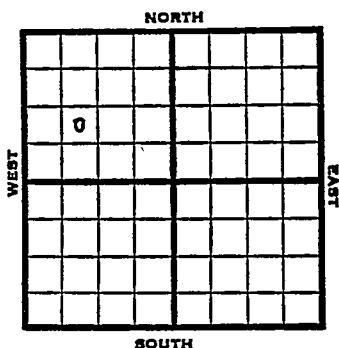

1953

Elev. 1326' REPORT

1/14

Spud 1-5-53

8" @ 390

Drlg. 2892'

1/23

Spud 1-5-53

D & A TD 3826' 8" @ 390'

Howard 1851 Top 1918' Heeb 2210'

Stal 2765 KC 3088 Marm 3316

Miss 3747 TD 3826'

D & A

ABANDONED

3088

3747

1326

1326

-1762-2421

County **Sumner** State **Kansas**

Sec. 1 (Blk. Twp.) 31 (Sur. Rge.) 2W Map No.

Operator J. P. Gatty et al.

Well No. 1 Farm Ingram

Elev.	Location	NE SW NW

0

FIRST REPORT

990 Ft. From S Line NW

990 Ft. From W Line Quarter

1st. Report JAN 14 1953

Completion

Remarks

H.M. Williams - Contr.

Spudding Date **1-5-53**

Orig. Data	Wildcat
------------	---------

8^u @ 390 drlg. 2892

J. G. McGEHEE

County Sumner State KansasSec. 1 (Blk. 31 (Sur. 2W Map No.)
(Twp.) (Rge.)Operator J. P. Gatty et al.Well No. 1 Farm IngramElev. 1326 Location NE SW NW

0						

990 Ft. From S Line NW990 Ft. From W Line Quarter1st. ReportCompletion JAN 23 1953Remarks WildcatH.M. Williams - Contr.Spudding Date 1-5-53Drilg. Data D & A TD 38268" @ 390 Howard 1851 Top. 1918Heeb. 2210 Stal. 2765 KC 3088Marm. 3316 Miss. 3747 TD 3826D & A