
DX 78-1 Harper

KANSAS

Section 1 Township 31 Range 8W

Well No. 1 McIntire

Company Champlin Ref.

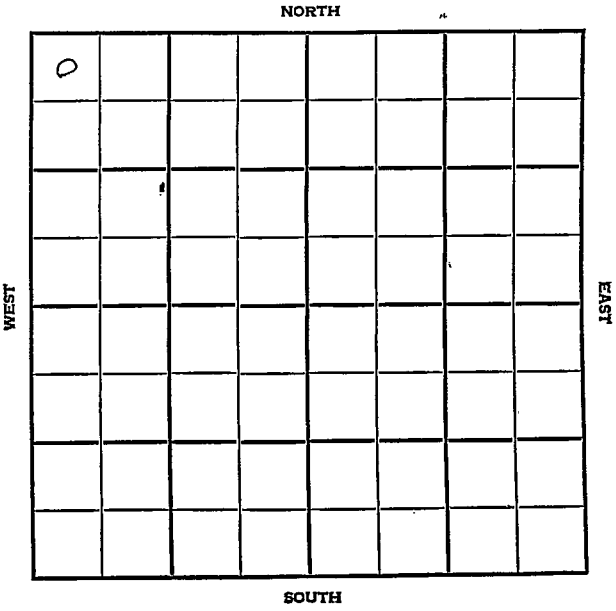

Harper KANSAS

SEC. HOLE | TWP. 31 | R. 8W

WELL NO. 1

1 McIntire FARM

COMPANY

Champlin Ref.

CONTRACTOR

Big Chief


Wildcat

330 Ft. from N. Line

Ft. from S. Line

Ft. from E. Line

330 Ft. from W. Line

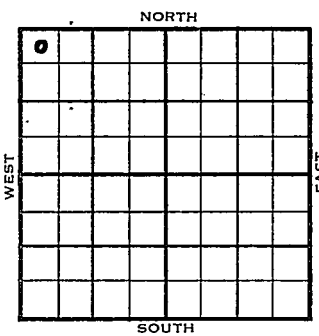

NW NW NW

Magnolia FO (1/4 mile Sunray)

1955	ELEVATION 1653' REPORT
4/27	Spud 4-25-55 8" @ 316', WOC
5/26	Frac F/load, F/31½ bo plus 26% wtr in 9 hr, plus 2,300 Mcfg
6/2	No report
6/9	Shut in
6/16	F/3.3 BO + 52 BW 24 hr. + 1,250 MCFG
6/23	F/3.3 BO + 62 BW 24 hrs, ¼ 1,250 MCFG WOP
6/29	Comm 4-25-55 Dg 3434 L 3643 3634 KC 3878 3878 M 4376 4378 TD 4407 4405 8" @ 316/175 DST 3915-50 open 2 hr Rec 540' Hgc & vsocm 720' SW 1425/20" DST 4370-92 failed DST 4369-92 open 1 hr 8 min gas to surface in 2 min 2,310 mcfg in 10 min. Rec 1170' mud 1800/20" DST 4391-4407 open 2 hr gas in 3 min 416 mcfg in20 min 391 mcfg 2 hr Rec 180' ho & gcm

DX-78

OVER

1955
6/29 300' sw 1543/20" DST 4378-4407 open 2 hr. gas in 3 min 1,250 mcfg in 10 min 1,450 mcfg in 20 min. S/ocm in 90 min. Rec 360' o & gcm 180' sw 90' drlg mud 1450/20" 5" @ 4405/150 CO to 4398 28/4380-87 F/600 mcfg frac F/31½ bo 26% wtr. 9 hr 2,300 mcfg F/3.3 bo 52 bw 24 hr 1,250 mcfg Comp F/3 bopd 97% wtr.

COMPLETED

FORM 275 FOR SALE BY KANSAS BLUE PRINT CO.


County Harper State Kansas

Sec. 1 (Blk. Twp.) 31 (Sur. Rge.) 8W Map No.

Operator Champlin Ref.

Well No. 1 Farm McIntire

Elev. Location NW NW NW

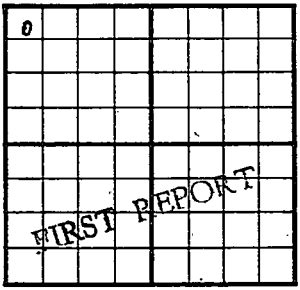

330 Ft. From N Line NW

330 Ft. From W Line Quarter

1st. Report APR 2 7 1955

Completion

Remarks Magnolia farmout

Big Chief - Contr.

Spudding Date 4-25-55

Drlg. Data Wildcat

8" @ 316 WOC

K-27

FABEN GILSTRAP

MAY 2 1955

Scout Cards	Aw
Land Small Map	
Land Wall Map	
Tracings	
France Map	
Pierce Mfg	
Misc.	a

Dtlg. Data

FORM 513 REV. SUNRAY

County Harper Elev. 1653 Co.

Sec. 1 Twp. 31 Rge. 8W

Company Champlin Ref.

Farm Name McIntire No. 1


TOPS	DEPTH	LOG	DATUM
Anh.			
Tp.			
H.			
Tr.			
Dg.		3434	1781
Bl.			
L.	3643	3634	1981
K.C.	3878	3878	2225
B.K.C.			
Ce.			
C.			
M.	4376	4378	2725
M.			
K.			
Mz.			
Mo.			
V.			
S.			
S.			
A			
R.			
P€.			
G.			
T.D.	4407	4405	

Loc. in Sec. NW NW NW

Geol.

Contr. Big Chief Lse.

Pool SE Spivey

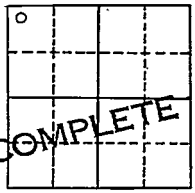

No.

Date Comm: 4-25-55 JUN 29 1955

Sec.

8" @ 316/175 DST 3915-50 open 2 hr.

Rec.- 540'hgc & vsocm 720' sw 1425/20"

DST 4370-92 failed DST 4369-92 T.

. open 1 hr. 8 min. gas to surface in 2 min.


2,310 mcfg in 10 min. Rec. 1170' mud

1800/20" DST 4391-4407 open 2 hr.

gas in 3 min. 416 mcfg in 20 min.

391 mcfg 2 hr. Rec. 180' ho & gcm R.

300' sw 1543/20" DST 4378-4407
open 2 hr. gas in 8 min. 1,250 mcfg
in 10 min. 1,450 mcfg in 20 min.
S/ ocm in 90 min. Rec. 360' o & gcm
180' sw 90' drlg. mud 1450/20"
5" @ 4405/150 CO to 4398 28/ 4380-87
F/ 600 mcfg frac F/ 31½ bo 26%wtr.
8 hr. 2,300 mcfg F/ 3.3 bo 52 bw
24 hr. 1,250 mcfg
Comp. F/ 3 bopd 97% wtr.

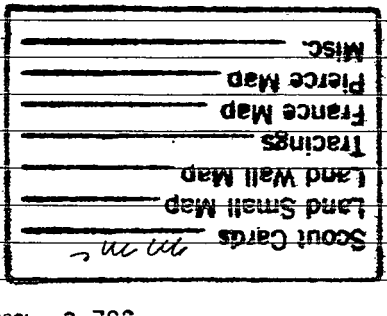

JUL 8 1955