

Section 23 Township 31 Range 8 WWell No. # 1 McIntireCompany Nate Appleman

NORTH

WEST

EAST

							0

SOUTH

Harper KANSAS

SEC.	TWP.	R.
23 /	31	8W

WELL NO.

1 McIntire

FARM

COMPANY

Nate Appleman

CONTRACTOR

Berwick Tools


Wildcat

330 Ft. from N. Line

Ft. from S. Line

330 Ft. from E. Line

Ft. from W. Line

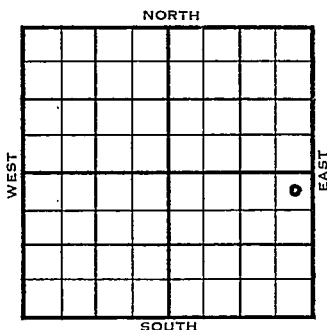

NE NE SE

	ELEVATION	REPORT
1954	1644'	

9/29 Location

10/20 Spud 9-29-54 D & A TD 4470
 8-5/8" @ 160 Lans 3657'
 DST 3912-45 open 1 hr rec 1700' SW
 1390# KC 3884 Miss 4391
 DST 4400-13 open 1 hr gas in 4 min
 200,000 CFG, 150' HOCM 1170#
 Miss. chat 4397'
 DST 4415-33, open 1 hr rec 90' SO &
 GCM, 420' SW 1160#
 DST 4435-58 open 1 hr rec 720' SW.
 1720# TD 4470' D & A

ABANDONED

County: **Harper** State: **Kansas**

Sec. **23** (Blk. **31** (Sur. **8W** Map No.

Operator Nate Appleman

Well No. **1** Farm **McIntire**

Elev.	Location	NE	NE	SE
-------	----------	----	----	----

[illegible]

330 Ft. From N Line SE

330 Ft. From E Line Quarter

1st. Report SEP 29 1954

Completion _____

Remarks

Berwick Tools

Spudding Date .

Drig. Data Wildcat

Location _____

FABEN GILSTRAP

Kansas

Map No. _____ Sec. 1 Twp. 31 R. 8WWell No. 1 McIntire

Nate Appleman

Company

Contractor

NE NE SE

CORRECTION


SECTION PLAT

330 Ft. from N. Line

Ft. from S. Line

330 Ft. from E. Line

Ft. from W. Line

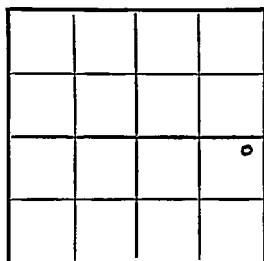

Harper County

Location _____

Rig up _____

Drilling and Remarks:

Reported

23-31-8W

RECORD

Cased _____ in., _____ ft.

Sand _____

Gas _____

Oil _____

Total Depth _____

PRODUCTION

1st 24 hrs. Nat. _____

1st 24 hrs. after shot _____

Gas _____ Cu. Ft.


Dry Hole _____

Abandoned _____

Date

OCT 6 1954
19FABEN GILSTRAP
Scout

County Harper State Kansas
 Sec. 1 (Blk. 31 (Sur. 8W Map No.
 (Twp. (Rge.
 Operator Nate Appleman
 Well No. 1 Farm McIntire
 Elev. 1644 Location NE NE SE

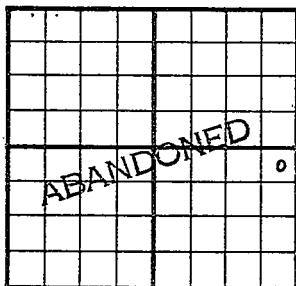

330 Ft. From N Line SE
330 Ft. From E Line Quarter
 Ist. Report _____
 Completion OCT 20 1954
 Remarks Wildcat
Berwick - Contr.
 Spudding Date 9-29-54

Drilg. Data D & A TD 4470
8 5/8" @ 160 Lans. 3657 DST 3912-45
open 1 hr. Rec. 1700' sw 1390#
KC 3884 Miss. 4391 DST 4400-13
open 1 hr. gas in 4 min. 200,000 cfg
150' hocm 1170# Miss. chat 4397
DST 4415-33 open 1 hr. Rec. 90' so & gcm
420' sw 1160# DST 4435-58 open 1 hr.
Rec. 720' sw 1720# TD 4470

D & A

FABEN GILSTRAP