

Harper


DX 78-1

KANSAS

Section 1 Township 31S Range 9W

Well No. #1 Lydia I. Gaug

Company Magnolia

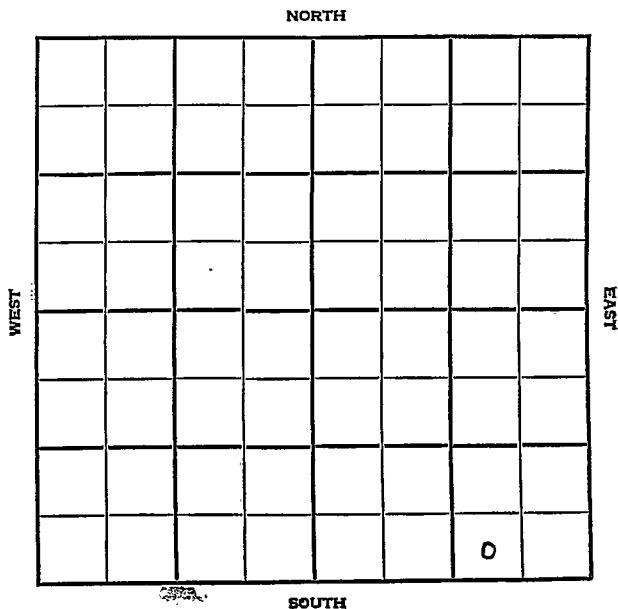

SEC.	TWP.	R.
1	31S	9W

WELL NO.

#1 Lydia I. Gaug

FARM

COMPANY

Magnolia

CONTRACTOR

Prime Tools.

Grabs.

Ft. from N. Line


330

Ft. from S. Line

990

Ft. from E. Line

Ft. from W. Line

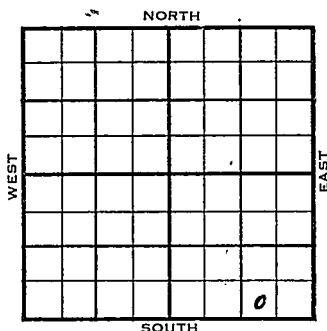

SW SE SE

	ELEVATION	REPORT
1954	1687'	

12/8

Spud 12-5-54

9" @ 209' w/250 sks.

Drlg. 310'

1955
2/16

Spud 12-5-54 Oil well TD 4546

9" @ 209' Lans 3672 Miss 4400

TD 4546 5" @ 4545 GO to 4509

24/4484-88 B/1 GO 29 GSWPH 7 hr.

100 M-A S/5 GO 100 GSW 4 hr.

36/4462-68 B/8 GW 4 hr. SP 4453

36/4444-50 B/140' oil 350' SW

Sq/ 36/4444-50 9 GOPH 5 GSWPH


10 hr. F/19 BO 2 BSW 4 hr.

2,938,000 CFG.

Comp. F/91 BOPD 11 BSW

COMPLETED

County **Harper** State **Kansas**
 Sec. **1** (Blk. **31S** (Sur. **9W** Map No.
 (Twp.) (Rge.)
 Operator **Magnolia**
 Well No. **1.** Farm **Lydia I. Gaug**
 Elev. Location **SW SE SE**

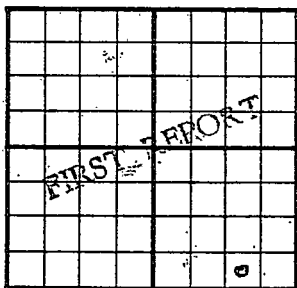

330 Ft. From **S** Line
990 Ft. From **E** Line **SE** Quarter
 1st. Report **DEC 8 1954**
 Completion
 Remarks **Prime tools**

Spudding Date **12-5-54**


Drlg. Data

Grabs

9" @ 209 w/250, Drlg 310

FABEN GILSTRAP

County Harper State Kansas
 Sec. 1 (Blk.) 31 (Sur.) 9W Map No.
 Operator Magnolia
 Well No. 1 Farm Lydia I. Gaug
 Elev. 1687 Location SW SE SE

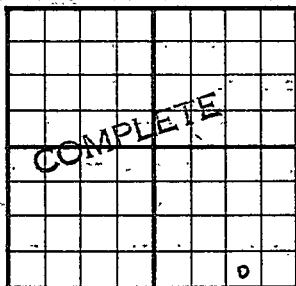

330 Ft. From S Line SE
990 Ft. From E Line Quarter
 Ist. Report
 Completion FEB 16 1955
 Remarks Grabs Pool
Prime Drlg. - Contr.
 Spudding Date 12-5-54

Drlg. Data Oil well TD 4546
9" @ 209 Lans. 3672 Miss. 4400
TD 4546 5" @ 4545 CO to 4509
24/ 4484-88 B/ 1 go 29 gswph 7 hr.
100-M-A S/ 5 go 100 gsw 4 hr.
36/ 4462-68 B/ 8 gw 4 hr. SP 4453
36/ 4444-50 B/ 140' oil 350' sw
sq/ 36/ 4444-50 9 goph 5 gswph
10 hr. F/ 19 bo 2 bsw 4 hr.
2,938,000 cfb
Comp. F/ 91 bopd 11 bsw

FABEN GILSTRAP