

WELL COMPLETION OR RECOMPLETION FORM
ACO-1 WELL HISTORY

Operator: license # 5555
name J. D. & B. Properties
address 4932 South Peoria
Tulsa OK 74105
City State Zip

Operator Contact Person R. C. Williams.....
Phone (918) 742-0738.....

Contractor: license # .. 5842
name GABBERT JONES, INC.

Site Geologist CLAUS AXELSEN
Phone (918)

☒ New Well	☒ Re-Entry	☒ Workover
--	--	--

Oil	SWD	Temp Abd
Gas	Inj	Delayed Comp.
Dry	Other (Core, Water Supply etc.)	

If **OWWO**: old well info as follows:

Operator
Well Name
Comp Date Old Total Depth

Drilling Method: ☒ Mud Rotary ☐ Air Rotary ☐ Cable

7/24/84	8/1/84	8/3/84
Spud Date	Date Reached TD	Completion Date

4536
Total Depth PBTD
4536
Amount of Surface Pipe Set and Cemented at 259 feet

Multiple Stage Cementing Collar Used? Yes ☒ No

If Yes, Show Depth Set feet

If alternate 2 completion, cement circulated
from feet depth to w/ SX cmt

Whelton log received
Sutton timber received

API NO. 15 - 007-21862

County BARBER

NW/4 . SE/4 . SE/4 Sec 17 Twp 31 Rge 10 Xv

990

14 ft North from Southeast Corner of Sect. 1.

1/4 West from Southeast Corner of Sect.

(Note: locate well in section plat below)


Lease Name INSLEE Well ZELMA

Field Name .. McREYNOLDS.....

Producing Formation ...MISSISSIPPI.....

Elevation: Ground ..1702.....KB 1707

Section Plot

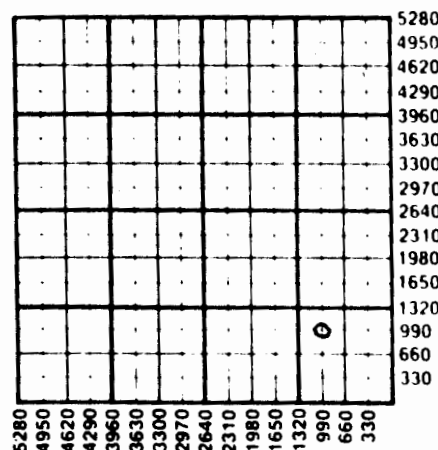

* WATER SUPPLY INFORMATION

Source of Water:

Division of Water Resources Permit # _____

Groundwater..... Ft North From Southeast Corner and
(Well)..... Ft. West From Southeast Corner

Sec	Twp	Rge	East	West
-----	-----	-----	------	------

X Surface Water... 330..... Ft North From Southeast Corner and
(Stream, Pond etc.) 330..... Ft West From Southeast Corner

Sec 20 Twp 31 Rge 10 East X West

☐ Other (explain)
(purchased from city, R.W.D.#)

Disposition of Produced Water:	Disposal	Repressuring
100%	0%	0%

Docket #

INSTRUCTIONS: This form shall be completed in duplicate and filed with the Kansas Corporation Commission, 200 Colorado Derby Building, Wichita, Kansas 67202, within 90 days after completion or recompletion of any well. Rules 82-3-130 and 82-3-107 apply.

Information on side two of this form will be held confidential for a period of 12 months if requested in writing and submitted with the form. See rule 82-3-107 for confidentiality in excess of 12 months.

of all wireline logs and drillers time log shall be attached with this form. Submit CP-4 form with all plugged wells. Submit CP-111 form with all abandoned wells.

SIDE TWO

Operator Name J. D. & B. PROPERTIES Lease Name INSLEE Well# 71 ^{Zolma} SEC 17 TWP. 31 RGE. 10 FILE ☒ V

WELL LOG

INSTRUCTIONS: Show important tops and base of formations penetrated. Detail all cores. Report all drill stem test giving interval tested, time tool open and closed, flowing and shut-in pressures, whether shut-in pressure reached surface level, hydrostatic pressures, bottom hole temperature, fluid recovery, and flow rates if gas to surface during test. Attach extra sheet if more space is needed. Attach copy of log.

Drill Stem Tests Taken ☒ Yes ☐ No
 Samples Sent to Geological Survey ☐ Yes ☒ No
 Cores Taken ☐ Yes ☒ No

Formation Description
☐ Log ☐ Sample

Name _____ Top _____ Bottom _____

SEE ATTACHED COPIES OF WELL REPORT & DST DISCUSSION

AUG 27 1984

State Geological Survey
WICHITA BRANCH

RECEIVED
 STATE CORPORATION COMMISSION

AUG 23 1984

CONSERVATION DIVISION
 Wichita, Kansas

CASING RECORD

Report all strings set - conductor, surface, intermediate, production, etc. ☒ new ☐ used

Purpose of string	size hole drilled	size casing set (in O.D.)	weight lbs/ft.	setting depth	type of cement	# sacks used	type and percent additives
SURFACE		8-5/8		259'	60/40 PMIX	200	2% Gel 3% CC
.....							
.....							
.....							

PERFORATION RECORD

shots per foot specify footage of each interval perforated

Acid, Fracture, Shot, Cement Squeeze Record
 (amount and kind of material used)

Depth

shots per foot	Acid, Fracture, Shot, Cement Squeeze Record (amount and kind of material used)	Depth
.....		
.....		
.....		
.....		
.....		

17-31-10W

GABBERT-JONES, INC.
WICHITA, KANSAS
DRILLERS' WELL LOG

ZELMA #1
NW SE SE
Sec. 17-31S-10W
Barber County, Kansas

Commenced: 7-24-84

Completed: 8-3-84

Operator: J D & B Properties

Depth		Formation	Remarks
From	To		
0	262	Sand-Redbed	Ran 6 jts. of 24# 8 5/8" csg. set @ 259' cemented w/200 sks 60/40 Posmix 2% Gel -- 3% CC
262	1250	Redbed-Shale	
1250	1710	Shale-Redbed-Lime	
1710	2175	Shale-Lime	PD @ 11:15 P.M. 7-24-84
2175	3585	Lime-Shale	
3585	3927	Lime-Shale-Sand	
3927	4536	Lime-Shale	

4536 TD

D & A

State of Kansas]

County of Sedgwick]

I, the undersigned, being duly sworn on oath, state
that the above Drillers' Well Log is true and correct
to the best of my knowledge and belief and according
to the records of this office.

AUG 27 1984

Geological Survey

GABBERT-JONES, INC.

[Handwritten signature]