

Barber

KANSAS

SECTION 10 TOWNSHIP 31 RANGE 10W

WELL NO. #1 Adams "C"

COMPANY Petroleum Inc.

NORTH SE NE SE

							o

WEST

EAST

SOUTH

Barber

KANSAS

SEC.	TWP.	R.
10	31 S	10 W

WELL NO.

1 Adams "C"

FARM

COMPANY

Petroleum Inc.

CONTRACTOR

Garvey Tools


Wildcat

_____ FT. FROM N. LINE

_____ FT. FROM S. LINE

_____ FT. FROM E. LINE

_____ FT. FROM W. LINE

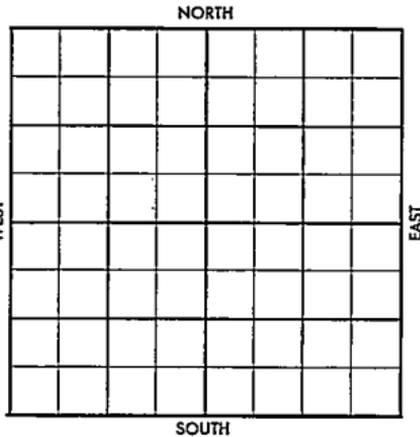

SE NE SE

SDX-3/4 Mile

1957	ELEVATION	REPORT
------	-----------	--------

5/1

Comm. 4-29-57

8" @ 247/175 WOC

(FR Tkt)

WILDCAT

FORM 513 SUNRAY

County Barber Elev. _____
 Sec. 10 Twp. 31 Rgs. 10W
 Company Petroleum Inc.
 Farm Name Adams "C" No. 1

TOPS	DEPTH	LOG	DATUM
Anh.			
Tp.			
H.			
Tr.			
Dg.			
Bl.			
L.			
K.C.			
B.K.C.			
Ce.			
C.			
M.			
M.			
K.			
Mz.			
Mo.			
V.			
S.			
S.			
A.			
R.			
PE.			
G.			
T.D.			

Loc. in Sec. SE NE SE

Geol. _____
 Contr. Garvey Tools

Pool Wildcat

FIRST REPORT
 MAY 1 1957
 3/4 mile

Date Comm. 4-29-57
8" @ 247/175, WOC

~~27~~

made in _____

Co. _____
 Lse. _____
 No. _____
 Sec. _____
 T. _____
 R. _____

County **Barber** Elev. **1173**
 Sec. **10** Twp. **31** Rge. **10W**
 Company **Petroleum Inc.**
 Farm Name **Adams "C"** No. **1**

TOPS	DEPTH	LOG	DATUM	Loc. in Sec.
Anb.				SE NE SE
Tr.				
H.	3627			
Tr.	3656			
Dg.	3678			
Bl.				
L.	3828			Geol.
Kt.	3835			Contr.
				Garvey Tools
				Pool
	4486			Wildcat
M.				<div style="border: 1px solid black; padding: 5px; text-align: center;"> <p>Wildcat</p> <p>ABANDONED</p> <p>MAY 15 '57</p> </div>
K.				
Mz.				
Mo.				
V.				
S.				
S.				
A.				
R.				
PE.				
G.				
TD.	4526			

Date Comm. **4-29-57**
8" @ 247/175, WOC *247 B 5'* *N 4011*
MAY 15 '57 *DST 4488-4506 1hr*
90' GCW + 1070' GCM BHP
1140/30"

DEW