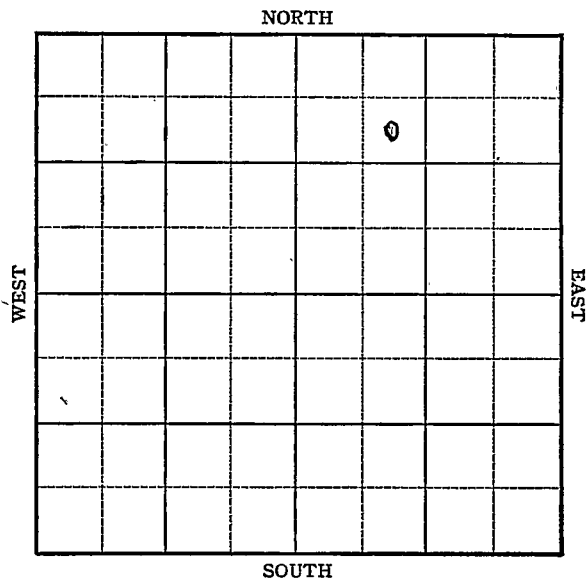


Section 10 Township 31 Range 14-WWell No. #1 HargisCompany Driller's Gas

KANSAS

Barber

Sec. 10 Twp. 31 R. 14-W

Well No. #1 Hargis Farm


Driller's Gas Company

990 Ft. from N. Line

Ft. from S. Line

Ft. from E. Line

990 Ft. from W. Line

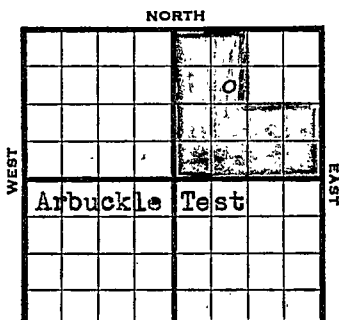

SE NW NE Hot File SOUTH Farm Out

1945 Elev. 1668' REPORT

12/12 Location

12/20 R.U.R.

12/29 10" - 790'
Shut down.

1946
1/10 Drlg. 1500'

1/17 Drlg. 3600'

1/24 Drlg. 4245'

1/31 Viola 4365' T.D. 4371'
7" - 4366'

2/7 TD 4373' 1000 acid.
248,000 cu ft gas.

2/14 T.D. 4374' 50 shots 4362-71'
3000 acid. Cleaning out.

2/20 S. Dat 4430'

~~2/28 R.U.R.~~

3/7 Arb. 4595'
T.D. 4623' SD

3/14 Top Arbuckle 4595'
Total Depth 4623'
Had very small show Gas from 4362-71'.
No Oil
Plugging

(Tel)

3/21 "

3/28 "

4/4 "

OVER

1946

4/10 Perf. 50 shots from 4362'-71'
3000 Acid
No shows
Drilled deeper
Top Arbuckle 4595'
Total Depth 4623' dry
They were given permission to plug
but did not plug the well.
Plugged back to 4368'
Perf. 6 shots 4359'-63'
" 5 shots 4354'-59'
" 7 shots 4354 $\frac{1}{2}$ '-60 $\frac{1}{2}$ '
No shows
Will perforate from 4363 $\frac{1}{2}$ ' to 4367 $\frac{1}{2}$ '
(Tel)

4/17 Arb. 4595
TD 4623'

ABANDONED

Kansas Pool Name HargisMap No. K 93 Sec. 10 Twp. 31 R. 14WWell No. 1 Hargis

Driller's Gas _____ Company _____

FIRST REPORT _____ Contractor _____


SE NW NE

SECTION PLAT

990 Ft. from N. Line

_____ Ft. from S. Line

_____ Ft. from E. Line

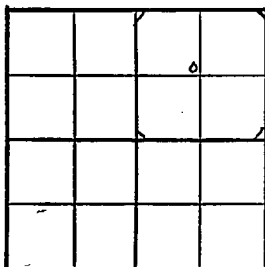990 Ft. from W. Line*on one side*
Barber CountyLocation X

Rig up _____

Drilling and Remarks:

RECORD

Cased _____ in., _____ ft.

Sand _____

Gas _____

Oil _____

Total Depth _____

PRODUCTION

1st 24 hrs. Nat. _____

1st 24 hrs. after shot _____

Gas _____ Cu. Ft.

Dry Hole _____

Abandoned _____

Date

DEC 1 2 1945 19

S. J. LEWIS

Scout

Misc. Small Maps
Cards *Budd*
Tracing *289*
France Map *L*
Scarborough Map *L*
Pierce Map *L*
Geological Dept.
Pierce Pist Book

KANSAS Kansas Pool Name HargisMap No. 93 Sec. 10 Twp. 31 R. 14WWell No. 1 Hargis

Driller's Gas

Company

ABANDONED

Contractor

SE NW NE

E11/68
SECTION PLAT990 Ft. from N. Line

Ft. from S. Line

Ft. from E. Line

990 Ft. from W. Line

Barber County

Location

Rig up

Drilling and Remarks:

Per 44595

RECORD

Cased _____ in., _____ ft.

Sand _____

Gas _____

Oil _____

Total Depth 4623

PRODUCTION

1st 24 hrs. Nat. _____

1st 24 hrs. after shot _____

Gas _____ Cu. Ft.

Dry Hole _____

Abandoned _____

Date

APR 17 1946 19

S. J. LEWIS

Scout

240 -

Misc. Small Maps	<i>CH</i>
Cards	<i>Garachy</i>
Tracing	<i>[Signature]</i>
France Map	<i>[Signature]</i>
Scarborough Map	<i>[Signature]</i>
Pierce Map	<i>[Signature]</i>
Geological Dept.	
Pierce Plat Book	