
DX 78-1

Stevens KANSAS

Section 10 Township 31 Range 38 W

Well No. # 1 Keefer

Company Hugoton Prod.

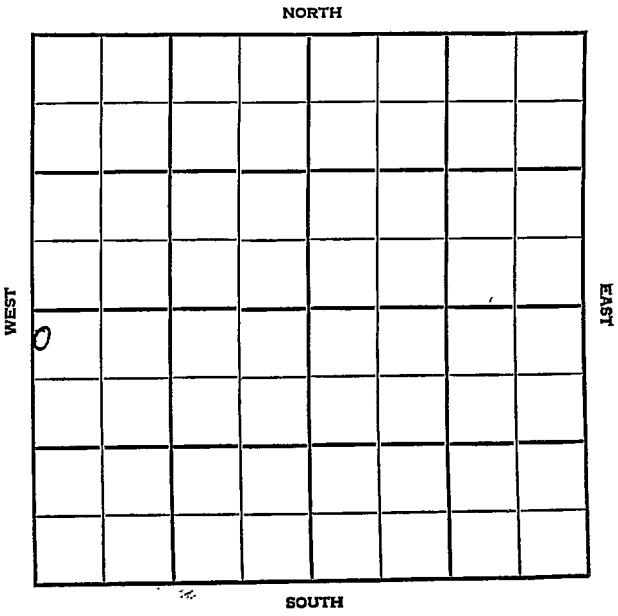

Stevens KANSAS

SEC.	TWP.	R.
10	31	38W

WELL NO. #1 Keefer FARM

COMPANY Hugoton Prod.

CONTRACTOR

Hugoton Pool


_____ Ft. from N. Line

2440 Ft. from S. Line

_____ Ft. from E. Line

150 Ft. from W. Line

NW NW SW

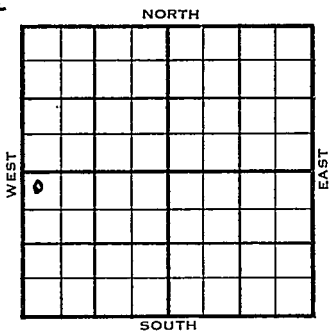

1954 ELEVATION	REPORT
11/17	Spud 11-13-54 7" @ 545' WOC.
12/29	Spud 11-13-54 Gas well TD 2639 ~~Hogt~~ Hol. 2379 Her. 2412 Kri. 2430 Win. 2493 Ft. Riley 2547 TD 2639 7" @ 2412 14,788,000 CFG 1000 A 23,584,000 CFG 16,000 A Comp. 56,023,000 CFGPD 393# COMPLETED

DX-78

FORM 275 FOR SALE BY KANSAS BLUE PRINT CO.


County Stevens State Kansas

Sec. 10 (Blk. Twp.) 31 (Sur. Rge.) 38W Map No.

Operator Hugoton Prod.

Well No. 1 Farm Keefer

Elev. Location NW NW SW

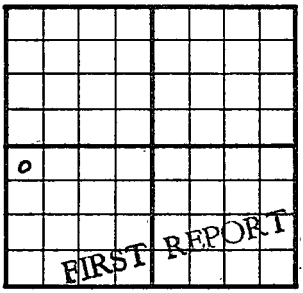

2440 Ft. From S Line SW

150 Ft. From W Line Quarter

1st. Report NOV 17 1954

Completion

Remarks

Spudding Date 11-13-54

Drlg. Data Hugoton Pool

7" @ 545 WOC

FABEN GILSTRAP

FORM 275 FOR SALE BY KANSAS BLUE PRINT CO.


County Stevens State Kansas

Sec. 10 (Blk. Twp.) 31 (Sur. Rge.) 38W Map No.

Operator Hugoton Prod.

Well No. 1 Farm Keefer

Elev. Location NW NW SW

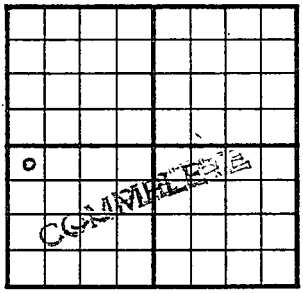

2440 Ft. From S Line SW

150 Ft. From W Line Quarter

1st. Report

Completion DEC 29 1954

Remarks Hugoton Pool

Spudding Date 11-13-54

Drlg. Data Gas well TD 2639

Hol. 2379 Her. 2412 Kri. 2430

Win. 2493 Ft. Riley 2547 TD 2639

7" @ 2412 14,788,000 cfg 1000 A

23,584,000 cfg 16000 A

Comp. 56,023,000 cfgpd 393#

FABEN GILSTRAP