


FORM 51 IOM 12-46 PETROL

Section 10 Township 31 Range 34N

Well No. 1 Stanley "B"

Company Cities Service

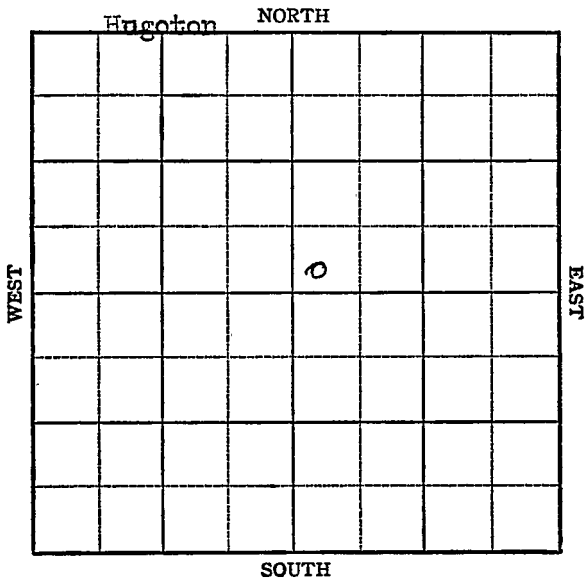

KANSAS Seward

Sec. 10 Twp. 31 R. 34W

Well No. #1 Stanley "B" Farm

Cities Service Company
Hugoton


 Ft. from N. Line

100 Ft. from S. Line

 Ft. from E. Line

100 Ft. from W. Line

SW NE

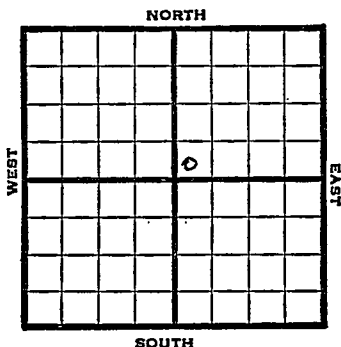

1947

REPORT

8/27 Location

9/3 "

9/10 "

9/17 "

9/24 "

10/1 "

10/8 "

10/15 8" @ 600'
Dr lg. 2650'

10/22 5" @ 2819
TD 2820'

10/29 "

11/5 "

11/12 "

11/19 "

11/25 130 shots. 2712-38' - 8000 acid.

OVER

1947

12/3 8500acid
100 shots. 2664-86'
170 shots. 2612-468'
50 shots. 2584-94'
50 shots. 2562-72'

12/10 "

12/17 5" @ 2819'
Perf 37000 acid
7,300,000 Gas
410# RPr
TD 2820

COMPLETED

Map No. _____ Sec. 10 Twp. 31 R. 34W

Well No. 1 Stanley "B"

_____ Cities Service _____ Company

FIRST REPORT

_____ Contractor

SW NE


SECTION PLAT

100 Ft. from N. Line

100 Ft. from S. Line

_____ Ft. from E. Line

100 Ft. from W. Line

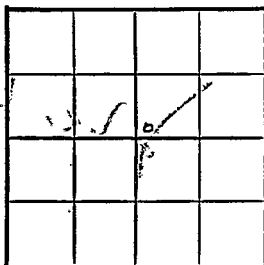

Seward County

Location X

Rig up _____

Drilling and Remarks:

RECORD

Cased _____ in., _____ ft.

Sand _____

Gas _____

Oil _____

Total Depth _____

PRODUCTION

1st 24 hrs. Nat. _____

1st 24 hrs. after shot _____

Gas _____ Cu. Ft.

Dry Hole _____

Abandoned _____

Date

AUG 27 1947 19

S. J. LEWIS

Scout

2

no map

Tracing

France Map

Scarborough Map

Pierce Map

Geological Dept.

Pierce Plat Book

JS

Map No. _____ Sec. 10 Twp. 31 R. 34W

Well No. 1 Stanley "B"

_____ Cities Service _____ Company

_____ COMPLETE _____ Contractor

SW NE

E 12 935
SECTION PLAT

_____ Ft. from N. Line

100 Ft. from S. Line

_____ Ft. from E. Line

100 Ft. from W. Line

Seward County

Location _____

Rig up _____

Drilling and Remarks:

5' test

Per f.

27000 acid

7,300,000 Gas

#10 R/B

RECORD

Cased _____ in., _____ ft.

Sand _____

Gas _____

Oil _____

Total Depth *2930*

PRODUCTION

1st 24 hrs. Nat. _____

1st 24 hrs. after shot _____

Gas _____ Cu. Ft.

Dry Hole _____

Abandoned _____

Date _____

DEC 17 1947 19

S. J. LEWIS Scout

[Handwritten signature]

Misc. Small Maps	<i>[initials]</i>
Cards	<i>Elaine</i>
Tracing	<i>[initials]</i>
France Map	<i>[initials]</i>
Scarborough Map	<i>[initials]</i>
Pierce Map	<i>[initials]</i>
Geological Dept.	
Pierce Plat-Book	

[Handwritten signature]