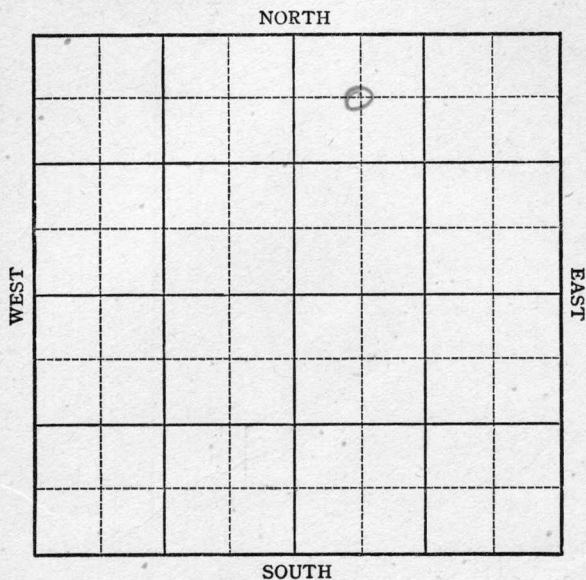


KANSAS

Section 10 Township 31 Range 17-WWell No. #1 FerrinCompany Huber Oil etal
Wildcat

KANSAS


Comanche

Sec. 10 Twp. 31 R. 17-WWell No. #1 Ferrin FarmHuber Oil etal Company

Wildcat

660 Ft. from N. Line Ft. from S. Line Ft. from E. Line660 Ft. from W. Line

C NW NE

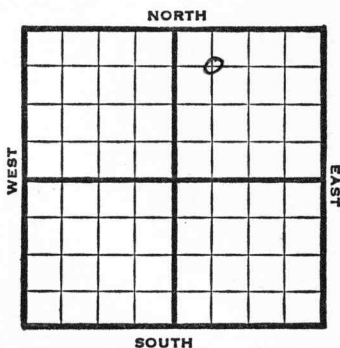

1947

REPORT

6/11 Location

6/17 "

6/24 RUR

7/1 10" @ 880'
WOC

7/8 Drlg. 3535'


7/16 Lansing 4301'
Drlg 4525'7/22 Mississippi 4986
Drlg. 51007/29 Viola 5267'
Simp. SW 5462'
Arbuckle 5566
TD 5595'8/6 Arbuckle 5566'
T.D. 5595'
Abandoned

ABANDONED

Map No. _____ Sec. 10 Twp. 31 R. 17WWell No. 1 FerrinHuber Oil etal. Company**FIRST REPORT**

Contractor

C NW NE

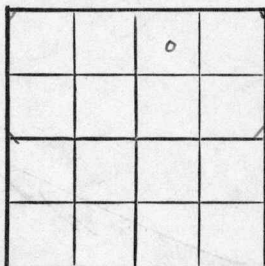SECTION PLAT660 Ft. from N. Line Ft. from S. Line Ft. from E. Line660 Ft. from W. LineComanche CountyLocation X

Rig up _____

Drilling and Remarks:

RECORD

Cased _____ in., _____ ft.

Sand _____

Gas _____

Oil _____

Total Depth _____

PRODUCTION

1st 24 hrs. Nat. _____

1st 24 hrs. after shot _____

Gas _____ Cu. Ft.

Dry Hole _____

Abandoned _____

Date

JUN 11 1947

19

S. J. LEWIS

Scout

Kansas

Wildcat

Map No. 94 Sec. 10 Twp. 31 R. 17WWell No. 1 Ferrin

Huber Oil etal.

Company

ABANDONED

Contractor

C NW NE

E12077

SECTION PLAT

660 Ft. from N. Line

Ft. from S. Line

Ft. from E. Line

660 Ft. from W. Line

		0	

Comanche County

RECORD

Location

Cased _____ in., _____ ft.

Rig up

Sand _____

Drilling and Remarks:

Gas _____

Oil _____

Total Depth 5595

PRODUCTION

1st 24 hrs. Nat. _____

1st 24 hrs. after shot _____

Gas _____ Cu. Ft.

Dry Hole _____

Abandoned _____

Date

AUG 6 1947 19

S. J. LEWIS

Scout