

Summer


FORM 51 5M BRIX

KANSAS

Section 10 Township 31 Range 1W

Well No. #1, R. Proud

Company Continental Oil Co.

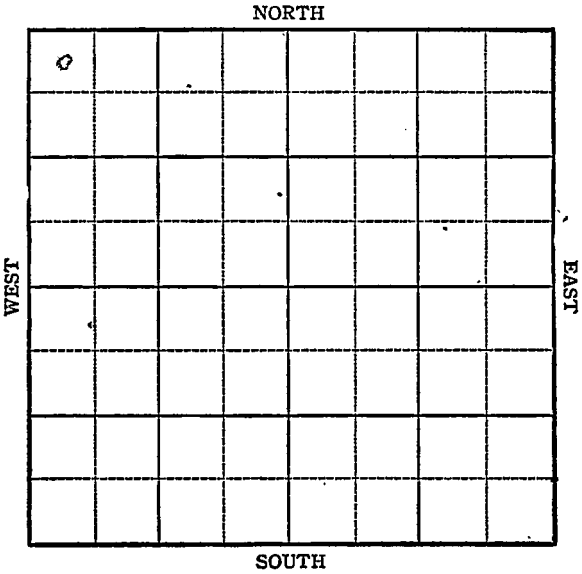


Sec. 10 Twp. 31 R. 1W

Well No. #1, R. Proud Farm

Continental Company

NORTH

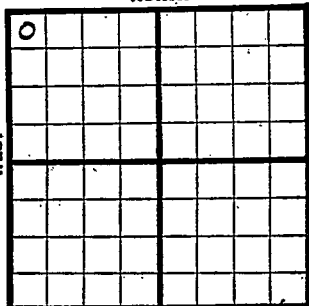

330 Ft. from N. Line

Ft. from S. Line

Ft. from E. Line

330 Ft. from W. Line

Elev. 1295

SOUTH

NW/C

1944

REPORT

- 6/7 Location
- 6/15 Derrick
- 6/21 30' SD
- 6/28 16" @ 74' WOC
- 7/12 Drlg. 1670
- 19
- 7/19 1925 crooked hole
FA PB 807 Drlg 835
- 7/26 Lost hole 1925 TD Skid rig 20' South
10" @ 336 WOC
- 8/2 Drlg. 2240
- 8/9 Drlg. 3495
- 8/16 KC 2988
Miss 3659
Drlg. 3840
- 8/23 Arb 4136
fsg 4150
- 8/30 Arb 4136
TD 4158

ABANDONED

KANSAS

Pool Name Wildcat

Map No. 31 Sec. 10 Twp. 31 R. 1W

Well No. I R. Proud

Continental Company

FIRST REPORT

Contractor

NW/C

SECTION PLAT

330 Ft. from N. Line

_____ Ft. from S. Line

_____ Ft. from E. Line

330 Ft. from W. Line

0			

Summer County

Location X

Rig up _____

Drilling and Remarks:

RECORD

Cased _____ in., _____ ft.

Sand _____

Gas _____

Oil _____

Total Depth _____

PRODUCTION

1st 24 hrs. Nat. _____

1st 24 hrs. after shot _____

Gas _____ Cu. Ft.

Dry Hole _____

Abandoned _____

Date

JUN 7 1944 19

S. J. LEWIS

Scout

Pool Name WellingtonMap No. 31 Sec. 10 Twp. 31 R. 1WWell No. 1 R. ProudContinental CompanyABANDONED Contractor

NW/C

SECTION PLAT

330 Ft. from N. Line Ft. from S. Line Ft. from E. Line330 Ft. from W. Line

Sumner County

0			

Location _____

Rig up _____

Drilling and Remarks:

Art 4/36

RECORD

Cased _____ in., _____ ft.

Sand _____

Gas _____

Oil _____

Total Depth 4158

PRODUCTION

1st 24 hrs. Nat. _____

1st 24 hrs. after shot _____

Gas _____ Cu. Ft.

Dry Hole _____

Abandoned _____

Date

AUG 3 0 1944

19

S. J. LEWIS

Scout