


Harper

Section 10 Township 31 Range 5WWell No. #1 SchlickauCompany Jones, Shelburne & Farmer

NORTH

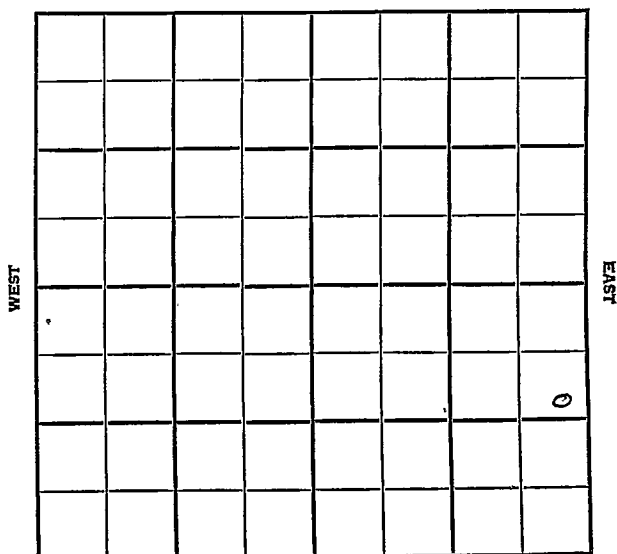

SOUTH

County Harper Elev. _____
 Sec. 10 Twp. 31 Rge. 5W
 Company Jones, Shelburne & Farmer
 Farm Name Schlickau No. 1

TOPS	DEPTH	LOG	DATUM
Anb.			
Tr.			
H.			
Tr.			
Dg.			
BL.			
L.			
K.C.			
B.K.C.			
Ce.			
C.			
M.			
M.			
K.			
Mz.			
Mq.			
V.			
S.			
S.			
A.			
R.			
PE.			
G.			
T.D.			

Loc. in Sec. _____

SE NE SE

Geol. _____

Contr. _____

Co. tools _____

Pool _____

Wildcat

FIRST REPORT	
JUN 8 '55	0

Date Comm. 6-1-55


Texas - AG

8" @259/175 drlg. 2720

K-28

County Harper Elev. 1350
 Sec. 10 Twp. 31 Rge. 5W
 Company Jones, Shelburne & Farmer
 FarmName Schlickau No. 1

	TOPS	DEPTH	LOG	DATUM	
Anh.	5221	3255	3245	1895	Loc. in Sec. <u>SE NE SE</u>
Tr.					
H.					
Tr.					
Dg.					
Bl.					
L.					
K.C.		3521	3517	2167	Geol. <u></u>
B.K.C.					Contr. <u></u>
Ce.					
C.					Co. tools <u></u>
M.		4174	4147	2797	
M.					Pool <u></u>
K.			4530	3180	Wildcat <u></u>
Mz.					
Mq.					
V.					
S.		4135	4133	3283	
S.					
A.		4756	4756	3406	
R.					
Pe.					
G.					
TD.		4770			

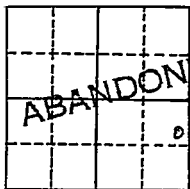

Date Comm. 6-1-55 JUL 6 1955
8" @ 259/175

D & A