DX 78-1

Harper KANSAS

Section 10 Township 31S Range 8W

Well No. 1 Muir "B"

Company Beardmore Drlg.

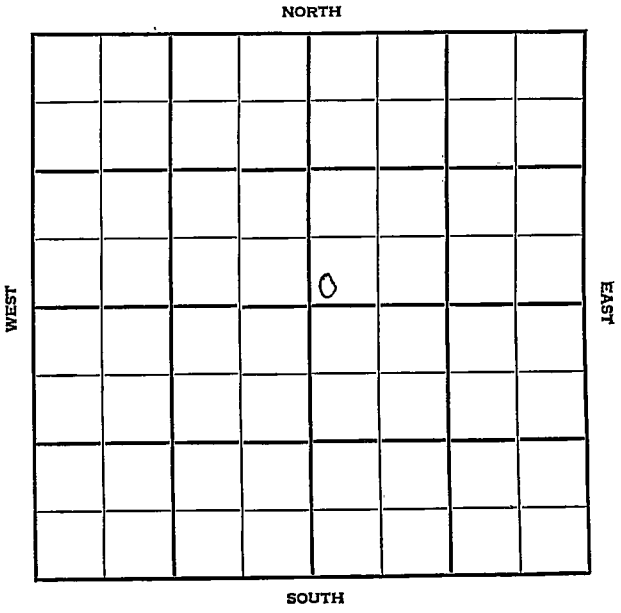

Harper **KANSAS**

SEC.	TWP.	R.
10	31S	8W

WELL NO. #1 Muir "B"

FARM

COMPANY Beardmore Drlg.

CONTRACTOR

Grabs East

_____ Ft. from N. Line

_____ Ft. from S. Line

_____ Ft. from E. Line

_____ Ft. from W. Line

SW SW NE

Sincl.-DHM

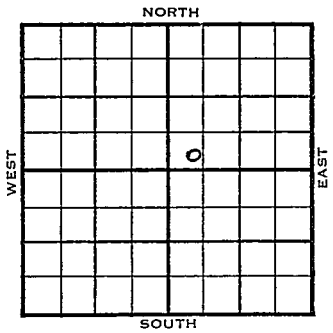

FIRST REPORT

1955	ELEVATION 1648' REPORT
7/13	Spud 6-28-55 Locl
8/17	8" @154 DST 4407-14 open 1 hr. gas in 14 min. 300 mcfg Rec. 40' gcm 1330# DST 4430-50 open 1 hr. gas in 27 min; Rec. 70' so & gcm 60' ho & gcm 210/20" DST 4431-58 open 1 hr, Rec. 60' ocm & w 60' gassy mud 30' wtr. 730/20" D&A L: 3647, 1999, KC: 3900, 22522 M; 4404; 2756 TD: 4505 **ABANDONED**

DX-78

FORM 513 REV. SUNRAY

County Harper Elev.

Sec. 10 Twp. 31S Rge. 8W

Company Beardmore Drlg.

Farm Name Muir "B" No. 1

TOPS	DEPTH	LOG	DATUM
Anh.			
T.P.			
H.			
Tr.			
Dg.			
B.L.			
L.			
K.C.			
B.K.C.			
Ce.			
C.			
M.			
M.			
K.			
Mz.			
Mg.			
V.			
S.			
S.			
A			
R.			
P€.			
G.			
T.D.			

Loc. in Sec. SW SW NE

Sincl. - DHM

Geol.

Contr.

Pool Grabs East

JUL 13 '55

OIL

FIRST REPORT

Date Comm. spud 6-28-55; loc.

Co. \ Lse. No. Sec. T. R.

FORM 513 REV. SUNRAY

County Harper Elev. 1648

Sec. 10 Twp. 31 Rge. 8W

Company Beardmore Drlg.

Farm Name Muir "B" No. 1

TOPS	DEPTH	LOG	DATUM
Anh.			
Tp.			
H.			
Tr.			
Dg.			
Bl.			
L.	3647		1999
K.C.	3908		2252
B.K.C.			
Ce.			
C.			
M.	4404		2757
M.			
K.			
Mz.			
Mo.			
V.			
S.			
S.			
A			
R.			
P€.			
G.			
T.D.	4585		

Loc. in Sec. SW SW NE

Geol.

Contr.

Pool E. Grabs

AUG 17 1955

D

ABANDONED

Co. Lse. No. Sec. T. R.

Date Comm. 6-28-55

8" @ 154 DST 4407-14 open 1 hr. gas in 14 min. 300 mcfg Rec. 40' gcm 1330# DST 4439-50 open 1 hr. gas in 27 min. Rec. 70' go & gcm 60' ho & gcm 210/20" DST 4431-58 open 1 hr. Rec. 60' so & gcm 60' o & gcm 60' ocm & w 60' gassy mud 30' w tr. 730/20"

D & A