


Section 11 Township 31 Range 11 W

Well No. # 1 Bergner

Company Petroleum Inc.

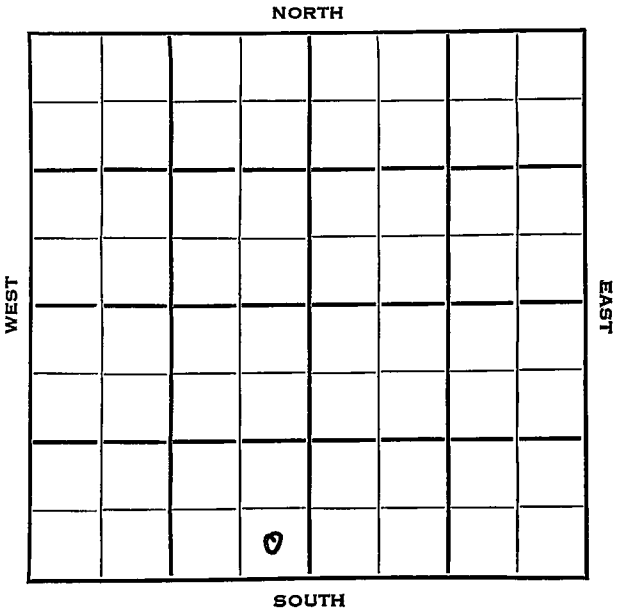

Barber

KANSAS

SEC.	TWP.	R.
11	31	11W ✓

WELL NO. #1 Bergner FARM

COMPANY Petroleum Inc.

CONTRACTOR Petroleum Inc.


Wildcat.

\_\_\_\_\_ Ft. from N. Line

330 \_\_\_\_\_ Ft. from S. Line

330 \_\_\_\_\_ Ft. from E. Line

\_\_\_\_\_ Ft. from W. Line

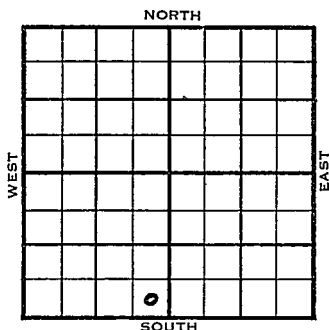

SE SE SW

Sunray, Skelly & NCRA

1953	ELEVATION 1783'	REPORT
------	--------------------	--------

11/24 Spud 11-20-53

8" @ 216'

Drlg 1940'

12/16 Spud 11-20-53

D & A

TD 4993'

8" @ 216'

Elgin Sd. 3650'

DST 3585'-3665' opn 1/2 hr, rec 6' Mud  
Doug. 3858'

DST 3827'-80' opn 1 hr, rec 780' sw .  
1080# Lans 3932', Miss 4518',

DST 4520'-40' opn 1 1/4 hr, rec 32' Mud  
O#. Kh. 4609', Viola 4764,

DST 4765'-95' opn 1/2 hr, rec 25' Mud O#  
Simp 4842'

DST 4836'-47' opn 1 hr, rec 30' Mud  
O#.

DST 4855'-57' opn 1 hr, rec 240' gas  
120' gcm 100# Arb 4962'

TD 4993'

D & A

ABANDONED



