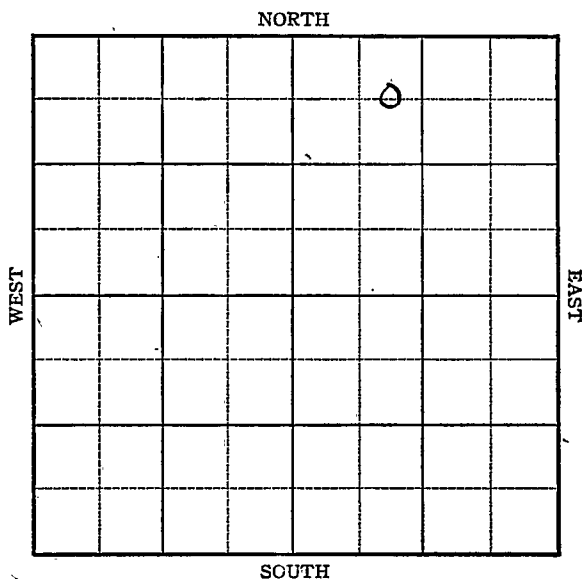


KANSAS

Barber County

Section 11 Township 31 Range 14WWell No. #1 Lake "B"Company Driller's Gas

KANSAS

Sec. 11 Twp. 31 R. 14-W

Well No. #1 Lake B Farm

Driller's Gas Company


Skinner

660 Ft. from N. Line

Ft. from S. Line

Ft. from E. Line

990 Ft. from W. Line

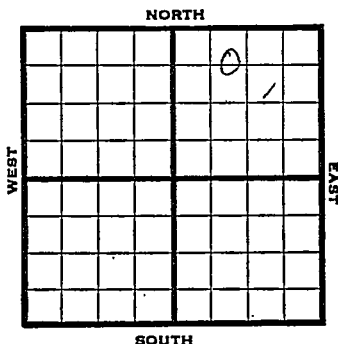

CEL NW NE

Elev. 1677

REPORT

1946

6/19

RUR

6/26

10" @ 810
Drlg 1826'

7/3

Drlg 2800'

7/9

Douglas 3772
Drlg 4140'

7/16

Magwoketa 4374'
TD 4375
7" @ 4375 RUST

7/23

TD 4383 $\frac{1}{4}$ M Gas

7/30

8000 acid
2,740,000 Gas

8/7

Maguoketa 4376
7" @ 4377
8000 acid.
TD 4383'
3 M. Gas.

COMPLETED

KANSAS

Kansas

Pool Name SkinnerMap No. 93 Sec. 11 Twp. 31 R. 14WWell No. 1 Lake "B"

Driller's Gas _____ Company

FIRST REPORT

Contractor _____

C E L NW NE

SECTION PLAT

660 Ft. from N. Line

_____ Ft. from S. Line

_____ Ft. from E. Line

990 Ft. from W. Line

Barber County

Location _____

Rig up _____

Drilling and Remarks:

RUR

RECORD

Cased _____ in., _____ ft.

Sand _____

Gas _____

Oil _____

Total Depth _____

PRODUCTION

1st 24 hrs. Nat. _____

1st 24 hrs. after shot _____

Gas _____ Cu. Ft.

Dry Hole _____

Abandoned _____

Date

JUN 19 1946 19 _____ S. J. LEWIS _____ Scout

Kansas Pool Name Skinner PoolKANSAS
Map No. 73 Sec. 11 Twp. 31 R. 14WWell No. 1 Lake "B"

Drillers Gas

Company

COMPLETED

Contractor

C E L NW NE

E1/1677
SECTION FLAT660 Ft. from N. Line Ft. from S. Line Ft. from E. Line990 Ft. from W. Line

		6	

Barber County**RECORD**Location Cased in., ft.Rig up Sand

Drilling and Remarks:

Gas Oil Total Depth 4973**PRODUCTION**1st 24 hrs. Nat. 1st 24 hrs. after shot Gas Cu. Ft.Dry Hole Abandoned

Magnum 4376
7" C 4377
8000 acid
3M Gas

Date

AUG 7 1946

19

S. J. LEWIS

Scout