


DX 78-1

Section 11 Township 31 Range 38W

Well No. #2 Grey

Company Hugoton Prod.

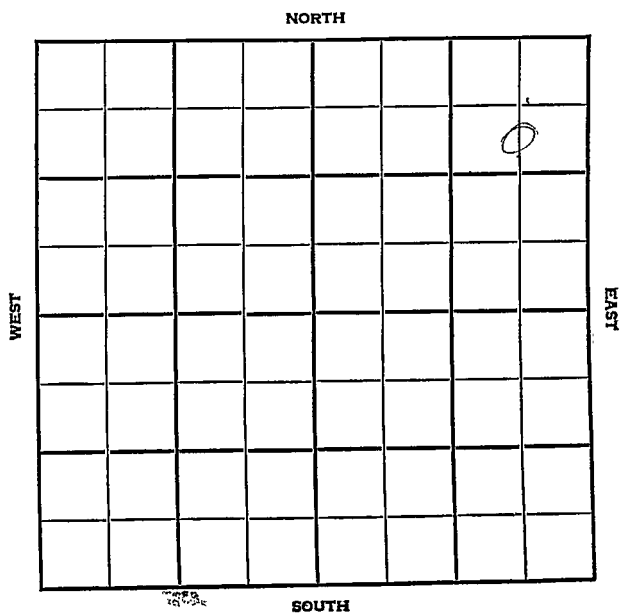

WILDCAT

FORM 513 SUNRAY

County Stevens Elev. 3044 Co.
 Sec. 11 Twp. 31 Rgs. 38W
 Company Hugaton Prod.
 FarmName Grey No. 2

TOPS	DEPTH	LOG	DATUM	Loc. in Sec.
Anh.				C S/2 NE NE
TP.				
H.				
Tr.				
Dg.				
BL.				
L.				Geol.
K.C.				Contr.
B.K.C.				Midwestern dr.
Ce.				
C.				Pool
M.				Wildcat
M.				
K.				
Mz.				
Mq.				
V.				
S.				
S.				
A.				
R.				
PE.				
G.				
T.D.				

Date Comm. spd. 11-19-56
 reaming @ 70', Miss tst.

34

County Stevens Elev. 3054
 Sec. 11 Twp. 31 Rge. 38W
 Company Hugoton Prod.
 Farm Name Grey No. 2-11

TOPS	DEPTH	LOG	DATUM	Loc. in Sec.
Anh. <u>Hall</u>		<u>2303</u>		<u>C S/2 NE NE</u>
Tr. <u>Hall</u>		<u>2347</u>		
H. <u>U. Kri</u>		<u>2364</u>		
Tr. <u>L Kri</u>		<u>2386</u>		
Dg. <u>W Ed</u>		<u>2436</u>		
Bl. <u>U. F. Rly</u>		<u>2492</u>		
L. <u>L " " "</u>		<u>2556</u>		
K.C. <u>REPA</u>		<u>2644</u>		Geol. _____
BKC. <u>cn grove</u>		<u>2692</u>		Contr. _____
Ce. <u>W</u>		<u>3093</u>		<u>Midwestern drl</u>
C. <u>TOP</u>	<u>3445</u>	<u>3454</u>		
M. <u>H6</u>	<u>3875</u>	<u>3872</u>		
M. <u>TR</u>	<u>3910</u>	<u>3904</u>		
K. <u>LSG-KC</u>	<u>3990</u>	<u>3980</u>		Pool _____
Mz. <u>Martn</u>	<u>4560</u>	<u>4600</u>		<u>Wildcat</u>
Mo. <u>CG</u>	<u>4763</u>	<u>4772</u>		
V. <u>ATO</u>	<u>5036</u>	<u>5052</u>		
S. <u>MW3H</u>		<u>5258</u>		
S. <u>chest</u>		<u>5614</u>		
A. <u>st 6 in</u>		<u>5722</u>		
R. _____				
PE. _____				
G. _____				
T.D. <u>5757</u>				COMPLETE

Date Comm. spd. 11-19-56reaming @ 70', Miss tst. NOV 28 '56 113"@ 515/500 Lost circ @ 2681

DEC - 56 Twist off Fishing DEC 12 '56

Run surf @ 2990 DEC 19 '56 8 5/82994/1250 @ 3903 DEC 26 '56Net 4720-27 30" rec 10' md. BHT1425/20" @ 5101 JAN 2 '57 - PB 2900JAN 9 '57 CO 24/2870-76 PB 285020/2822-27 IN 90 3.818 MZEG

16/2811-15/2 ga 5.777 MCFW
 in 11 hrs PB 2808 36/2752
 -61 A ga 4.648 MCF 40/2777
 -81 24/2794-2800 /3 ga
 5.861 MCF in 12 hrs CO 2850
 /12 JAN 16 '57 15 hrs BD ga
 7.4448 MCF /3 7 hrs BD
 ga 8.014 MCF 7" CS9 A
 7 hrs BD ga 8.208 MCF (sour)
 PW2351 72-20 ga. 15.860 MCF
 RP 367# (gas sour)