

KANSAS

Stevens


FORM 51 IOM 12-46 PETROL

Section 11 Township 31 Range 36-W

Well No. 1 ~~Gilbert~~ Reynolds.

Company Magnolia

Hugoton Pool

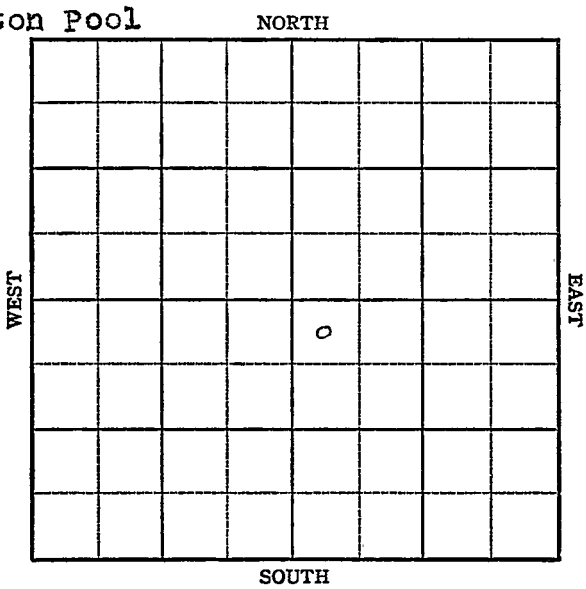

1

Sec. 11 Twp. 31 R. 36W

Well No. #1 ~~Gilbert~~ Reynolds Farm

Magnolia Company


Hugoton

330 Ft. from N. Line

\_\_\_\_\_ Ft. from S. Line

\_\_\_\_\_ Ft. from E. Line

330 Ft. from W. Line

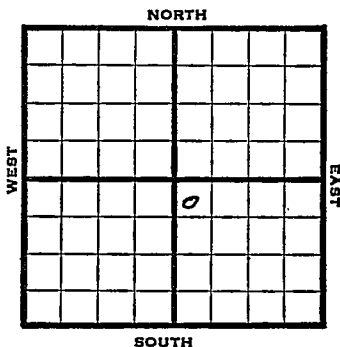

NW SE

1947 Elev. 8027' REPORT

9/24 Drlg. 600'

10/1 SD

10/8 10" @ 756'  
Drlg. 1590'

10/15 Drlg. 2598'

10/22 7" @ 2800TD  
191 shots 2695-2737-7000 acid  
12- " 2641-65 -7000 acid

11/5 7" @ 2800'  
Perf.  
Acid 2000  
Gas 13,600,000  
Rock Pressure 425#  
Total Depth 2800'

**COMPLETED**

Map No. \_\_\_\_\_ Sec. 11 Twp. 31 R. 36W

Well No. 1 Gilbert

Magnolia Company

**FIRST REPORT**

Contractor \_\_\_\_\_

NW SE

**SECTION PLAT**

330 Ft. from N. Line

\_\_\_\_\_ Ft. from S. Line

\_\_\_\_\_ Ft. from E. Line

330 Ft. from W. Line

		o	

Stevens County

Location \_\_\_\_\_

Rig up \_\_\_\_\_

Drilling and Remarks:

drlg. 600

**RECORD**

Cased \_\_\_\_\_ in., \_\_\_\_\_ ft.

Sand \_\_\_\_\_

Gas \_\_\_\_\_

Oil \_\_\_\_\_

Total Depth \_\_\_\_\_

**PRODUCTION**

1st 24 hrs. Nat. \_\_\_\_\_

1st 24 hrs. after shot \_\_\_\_\_

Gas \_\_\_\_\_ Cu. Ft.

Dry Hole \_\_\_\_\_

Abandoned \_\_\_\_\_

Date

SEP 24 1947 19

S. J. LEWIS Scout

Map No. ① Sec. 11 Twp. 31 R. 36<sup>W</sup>

Well No. 1 Reynolds

Magnolia Company

**CORRECTION** Contractor

NW SE

SECTION PLAT

330 Ft. from N. Line

\_\_\_\_\_ Ft. from S. Line

\_\_\_\_\_ Ft. from E. Line

330 Ft. from W. Line

		o	

Stevens County

Location \_\_\_\_\_

Rig up \_\_\_\_\_

Drilling and Remarks:

Reported

#1 Gilbert

RECORD

Cased \_\_\_\_\_ in., \_\_\_\_\_ ft.

Sand \_\_\_\_\_

Gas \_\_\_\_\_

Oil \_\_\_\_\_

Total Depth \_\_\_\_\_

PRODUCTION

1st 24 hrs. Nat. \_\_\_\_\_

1st 24 hrs. after shot \_\_\_\_\_

Gas \_\_\_\_\_ Cu. Ft.

Dry Hole \_\_\_\_\_

Abandoned \_\_\_\_\_

Date

OCT 1 1947 19

S. J. LEWIS Scout

Map No. \_\_\_\_\_ Sec. 11 Twp. 31 R. 36W

Well No. 1 Reynolds

Magnolia Company

COMPLETE Contractor

NW SE

*E18027*  
SECTION PLAT

330 Ft. from N. Line

\_\_\_\_\_ Ft. from S. Line

\_\_\_\_\_ Ft. from E. Line

330 Ft. from W. Line

		6	

Stevens County

Location \_\_\_\_\_

Rig up \_\_\_\_\_

Drilling and Remarks:

*7" C2800  
Perf.  
21600 acid  
13,600,000 Gas*

*425 # R/A*

RECORD

Cased \_\_\_\_\_ in., \_\_\_\_\_ ft.

Sand \_\_\_\_\_

Gas \_\_\_\_\_

Oil \_\_\_\_\_

Total Depth 2800

PRODUCTION

1st 24 hrs. Nat. \_\_\_\_\_

1st 24 hrs. after shot \_\_\_\_\_

Gas \_\_\_\_\_ Cu. Ft.

Dry Hole \_\_\_\_\_

Abandoned \_\_\_\_\_

Date

NOV 5 1947 19

S. J. LEWIS Scout