


KANSAS Seward County

FORM 51 5M PETROL

Section 11 Township 31 Range 34W

Well No. 1 Reed

Company Stevens County Oil and Gas

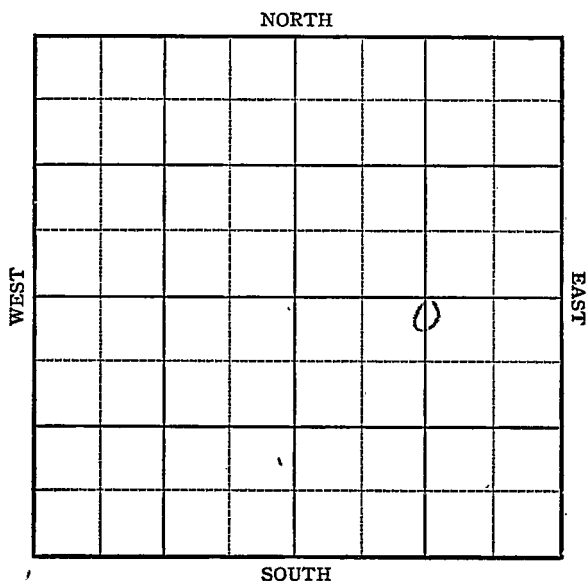

KANSAS

Seward

Sec. 11 Twp. 31 R. 34W

Well No. 1 Reed Farm

Stevens County Oil and Gas Company.


Hugoton

330 Ft. from N. Line

 Ft. from S. Line

1320 Ft. from E. Line

 Ft. from W. Line

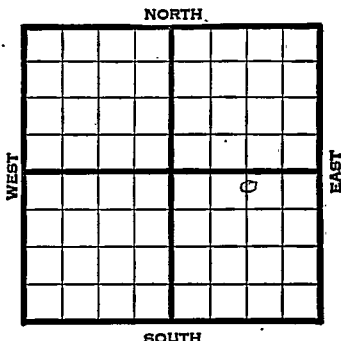

C N LSE Elev. 2942

1945	REPORT
6/13	Location
6/21	10" @ 543 WOC
6/28	7" @ 2555
7/3	TD 2560 RUST
7/11	" " "
7/19	TD 2743
7/26	5,758,000 Gas
8/2	" " "
8/8	TD 2743
8/15	5,758,000 Gas
8/22	" "
8/29	" "
9/5	" "
9/12	" "
9/19	" "
9/26	" "
10/3	1000 acid.
10/10	9,042,000 Gas
	7" @ 2555
	10000 acid.
	TD 2743
	9,042,000 Gas.
	426# R Pr.
	COMPLETED

Kansas Pool Name HugotonMap No. 220 ^{map} Sec. 11 Twp. 31 R. 34WWell No. 1 ReedStevens County Oil and Gas Company**FIRST REPORT**

Contractor

C N LSE

SECTION PLAT330 Ft. from N. Line Ft. from S. Line1320 Ft. from E. Line Ft. from W. Line

Seward County

			o

Location XRig up

Drilling and Remarks:

RECORDCased in., ft.Sand Gas Oil Total Depth **PRODUCTION**1st 24 hrs. Nat. 1st 24 hrs. after shot Gas Cu. Ft.Dry Hole Abandoned

Date

JUN 13 1945 19S. J. LEWIS

Scout

no wall - P


Lib. Engravings	N
Carls	22
Tracing	
France Map	
Scarborough Map	22
Pierce Map	
Geological Dept.	
Pierce Plot Book	

KANSAS

Kansas Pool Name HugotonMap No. Wm up Sec. 11 Twp. 31 R. 34WWell No. i ReedStevens County Oil & Gas Company**COMPLETED**

Contractor

C N L SE

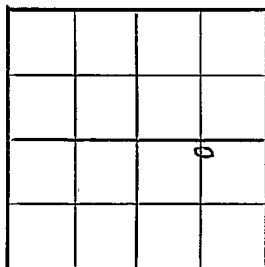E12942**SECTION PLAT** Ft. from N. Line330 Ft. from S. Line Ft. from E. Line1320 Ft. from W. Line

Seward County

Location Rig up

Drilling and Remarks:

7" 225055
10000 acid
9,143,000 Gas

426² R. P2**RECORD**Cased in., ft.Sand Gas Oil Total Depth 2748**PRODUCTION**1st 24 hrs. Nat. 1st 24 hrs. after shot Gas Cu. Ft.Dry Hole Abandoned

Date

OCT 10 1945

19

S. J. LEWIS

Scout

no well

Misc. Small Maps.....

Cards.....

Tracing.....

France Map.....

Scarborough Map.....

Moody Map.....

Geological Dept.....

Moody Plat Book.....