


Section 11 Township 31 Range 33W

Well No. #1 Kasel Gas Unit

Company Stanolind

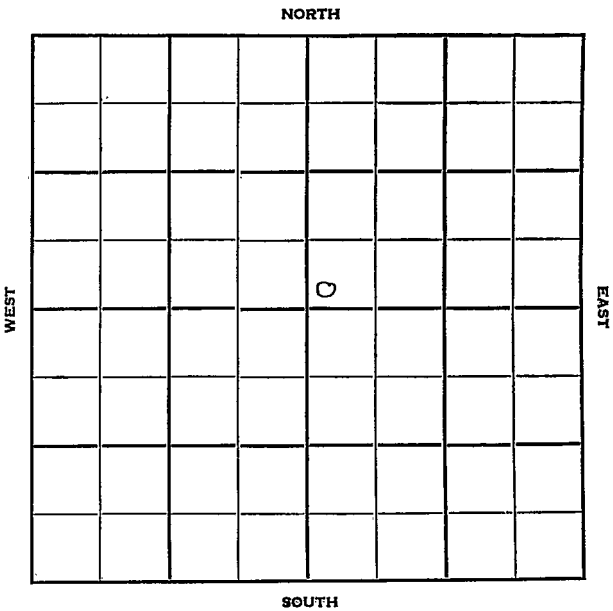

Sec. 11 Twp. 31 R. 33W

Well No. #1 Kasel Gas Unit Farm

Stanolind Company

Hugoton Pool Contractor


_____ Ft. from N. Line

150 Ft. from S. Line

_____ Ft. from E. Line

150 Ft. from W. Line

SW NE

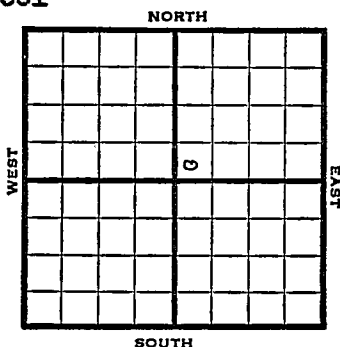

1952 Elev. 2888' REPORT

7/30	Location
8/6	"
8/13	"
8/20	"
8/27	"
9/3	Drlg. 631
9/10	RTD 2725 5" @ 2694
9/17	DD 2725' 66/ 2618-29 36/ 2632-38
	12/ 2640-42 60/ 2654-64
	54/ 2668-77 24/ -2682-86
	2500 A Hol. 2584
	Her 2615 Krider 2654
	Winfield 2694
9/24	.NR
10/1	Spud 8-27-52
	Gas Well TD 2725' 10" @ 630'
	7" @ 2694' TD 2725'
	66/ 2618-29 36/ 2632-38
	12/ 2640-42 60/ 2654-64
	54/ 2668-77 24/ 2682-86
	Hol. 2584 Her. 2615
	Kri. 2654 Win. 2694
	18500 A Comp. 8,800,000 gas

COMPLETED

