

KANSAS

Harper

Section 11 Township 31 Range 5WWell No. 1 MoffittCompany Gillespie & SonsWildcat

NORTH

						0	

WEST

EAST

SOUTH

KANSAS

Harper

Sec. 11 Twp. 31 R. 5W ✓

Well No. #1 Moffitt Farm

Gillespie & Sons Company

Wildcat (Sumit Drlg. Company)


330' Ft. from N. Line

 Ft. from S. Line

990' Ft. from E. Line

 Ft. from W. Line

NW NE SE

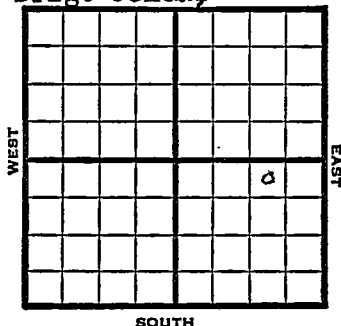

1949

Elev 1364' REPORT

6/22	Location
6/28	"
7/6	"
7/12	"
7/20	"
7/27	"
8/3	"
8/10	10" @ 161'
	Drlg. 1695'
8/17	KC 3528'
	Drlg. 3670'
8/24	Drlg. 4550'
8/31	TD 4794'
	Simp 4639'
	Arb. 4729'
	Aband.

3528
1364

2164

ABANDONED


Kansas

Map No. _____ Sec. 11 Twp. 31 R. 5WWell No. 1 Moffitt

Gillespie & Sons _____ Company

Sumit Drlg. _____ Contractor

NW NE SE

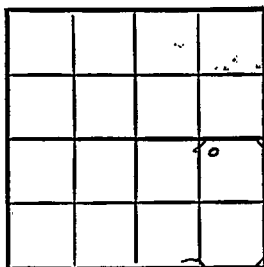FIRST REPORT
SECTION PLAT330 _____ Ft. from N. Line

_____ Ft. from S. Line

990 _____ Ft. from E. Line

_____ Ft. from W. Line

Harper County

Location X

Rig up _____

Drilling and Remarks: _____

RECORD

Cased _____ in., _____ ft.

Sand _____

Gas _____

Oil _____

Total Depth _____

PRODUCTION

1st 24 hrs. Nat. _____

1st 24 hrs. after shot _____

Gas _____ Cu. Ft.

Dry Hole _____

Abandoned _____

Date

JUN 22 1949 19S. J. LEWIS Scout

Map No. K32 Sec. 11 Twp. 31 R. 5W

Well No. 1 Moffett

Gillespie & Sons Company

ABANDONED

Contractor

NW NE SE

E11364
SECTION PLAT

330 Ft. from N. Line

 Ft. from S. Line

990 Ft. from E. Line

 Ft. from W. Line

			6

Harper County

RECORD

Location

Cased in., ft.

Rig up

Sand

Drilling and Remarks:

Gas

Oil

Total Depth 4724

PRODUCTION

1st 24 hrs. Nat.

1st 24 hrs. after shot

Gas Cu. Ft.

Dry Hole

Abandoned

Date

AUG 31 1949

19

S. J. LEWIS

Scout