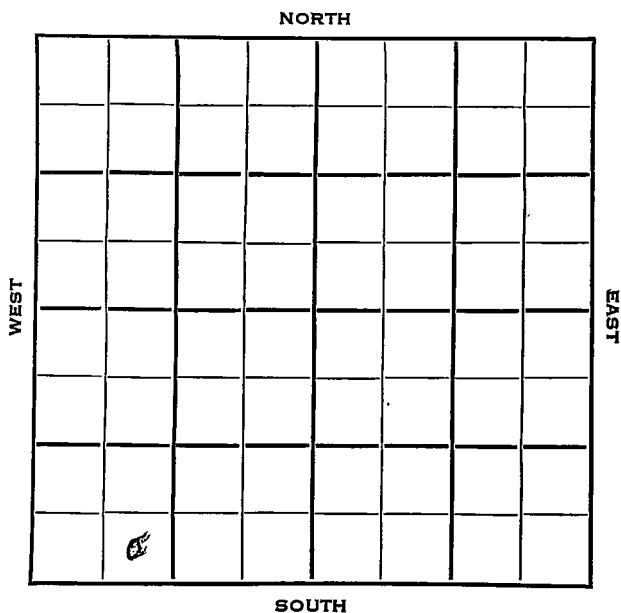


Section 11 Township 31 Range 8WWell No. 1 WilliamsCompany Beardmore Drlg.

Harper KANSAS
 SEC. TWP. R.
 11 31 8 W ✓
 WELL NO.
 # 1 Williams FARM
 COMPANY

Beardmore Drlg.
 CONTRACTOR

Beardmore
 Wildcat


Ft. from N. Line

330 Ft. from S. Line

Ft. from E. Line

990 Ft. from W. Line

SE SW SW

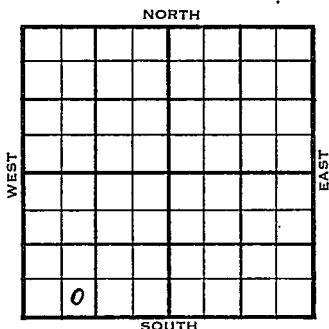

Stanolind - DHM

ELEVATION

REPORT

1954 1634'

3/10 RUR

3/17 8" @ 175 w/110 sks
 Drlg 3490'

3/24 Spud 3-9-54

D & A

TD 4493'

8" @ 175'

Win 1650', Tow 1700' Ft. Riley 1740'

Top 2989', Heeb 3380', Lans 3905' Miss

4424'

TD 4493'

D & A

ABANDONED

County **Harper** State **Kansas**

Sec. **11** (Blk. **31** (Sur. **8W** Map No.

Operator **Beardmore Drlg.**

Well No. **1** Farm **Williams**

Elev.	Location	SE	SW	SW
-------	----------	----	----	----

FIRST REPORT

330 Ft. From S Line SW

990	Ft. From	W Line	Quarter
-----	----------	--------	---------

1st. Report MAR 10 1954.

Completion

Remarks Stanolind - DAM

Beardmore - Contr.


Spudding Date _____

Drig. Data **Wildcat**

R U R

J. G. McGEHEE

County Harper State Kansas
 Sec. 11 (Blk.) 31 (Sur.) 8W Map No.
 Operator Beardmore Drlg.
 Well No. 1 Farm Williams
 Elev. 1634 Location SE SW SW

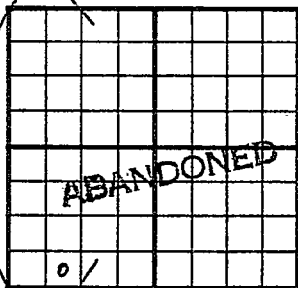

330 Ft. From S Line SW
990 Ft. From W Line Quarter
 1st. Report
 Completion MAR 24 1954
 Remarks Wildcat
Beardmore - Contr.
 Spudding Date 3-9-54.

Drlg. Data D & A TD 4493
8" @ 175 Win. 1650 Tow. 1700
Ft. Riley 1740 Top. 2989 Heeb. 3380
Lans. 3905 Miss. 4424 TD 4493

D & A

J. G. McGEHEE