


Harper

KANSAS

SECTION 11 TOWNSHIP 31S RANGE 9W

WELL NO. #1 Drake-Ryan

COMPANY Rupp-Ferguson Oil

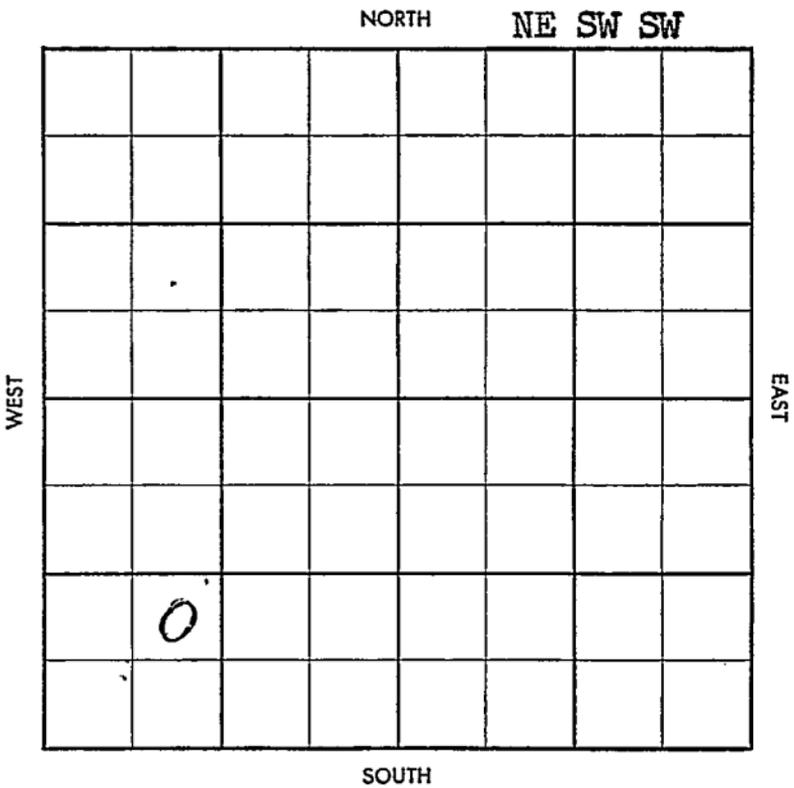

~~Tr.~~ ~~Pool~~
~~Co.~~ ~~Foot~~

S-513-B

County Harper Elev. _____
 Sec. 11 Twp. 31 Rge. 9W
 Company Rupp-Ferguson Oil
 Farm Name Orake-Ryan No. 1


TOPS	DEPTH	LOG	DATUM
Anh.			
Tp.			
H.			
Tr.			
Dg.			
B.L.			
L.			
K.C.			
B.K.C.			
Ce.			
C.			
M.			
M.			
K.			
Mz.			
Mq.			
V.			
S.			
S.			
A.			
R.			
Pf.			
G.			
T.D.			

Loc. in Sec. _____
NE SW SW
 Geol. _____
 Contr. _____
 Pool _____
Spivey-Grabs

FIRST REPORT
 MAY 28 1958

Date Comm. _____
 Location _____

Co.
 Lse.
 No.
 Sec.
 T.
 R.

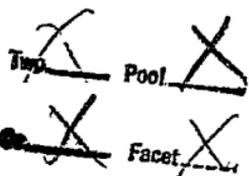

S-513-B

County Harper Elev. 16670 OF 167088
 Sec. 11 Twp. 31 Rge. 9W
 Company Rupp-Ferguson Oil
 Farm Name Drake-Ryan No. 1

TOPS	DEPTH	LOG	DATUM
Anh.			
Tp.			
H.			
Tr			
Dg.	<u>3511</u>		
B.L.			
L.	<u>3666</u>		
K.C.			
B.K.C.			
Ce.			
C.			
M.	<u>4400</u>		
M.			
K.			
Mz.			
Mq.			
V.			
S.			
S.			
A.			
R.			
Pf			
G.			
T.D.	<u>4469</u>		

Loc. in Sec. NE SW SW
 Geol. AKius
 Contr. _____
 Pool _____
Spives-Grabs

COMPLETE
 JUL 16 '58

Date Comm. 6-2-58 8'246/185
 Location JUN 3 '58 JUN 11 '58 @ 2980 JUN 18 '58

DST 4405-40 60" 9/13" ga 2.600
mf 50' 40' gem 100' g 60 C M
BHP 1600 DST 4420-40 60" 9/13"
ga 1.250 mf 15" ga 2.630/20"
mf log 5" JUN 25 '58 4468 #5
64/4410-29 (A) Frac 20x20 Flo
Ld + gas 51 Tanks JUL 2 '58 Flo Ld
ga 2.500 mf / spray oil FTP
1180 SITP 1360 51

JUL 9 58

510 5.700 - mcf

15 B Ld oil 4 hrs SITD 1099

JUL 16 58

Ca by Flo 5.200 MCF

SITD 1300

MISS 4410-24