

RELEASED

3/5/86
3-5-87
KCC Ind

SIDE ONE

Date: APR 1 1987
STATE CORPORATION COMMISSION OF KANSAS
OIL & GAS CONSERVATION DIVISION
FROM CONFIDENTIAL

WELL COMPLETION OR RECOMPLETION FORM
ACO-1 WELL HISTORY

DESCRIPTION OF WELL AND LEASE

Operator: License # 7963
Name Fancher Oil Company
Address 1801 California Street
Suite 4450
City/State/Zip Denver, Colorado 80202

Purchaser.....

Operator Contact Person Stephen W. Barnes
Phone 303-296-6600

Contractor: License # 5302
Name Red Tiger Drilling Company

Wellsite Geologist Michael J. Walsh
Phone (303) 296-6600

Designate Type of Completion
 New Well Re-Entry Workover

Oil SWD Temp Abd
 Gas Inj Delayed Comp.
 Dry Other (Core, Water Supply et

If OWWO: old well info as follows:

Operator
Well Name
Comp. Date Old Total Depth.....

WELL HISTORY

Drilling Method:
 Mud Rotary Air Rotary Cable
11/23/85 12/5/85 12/5/85
Spud Date Date Reached TD Completion Date
4,700' Surface
Total Depth PBTD

Amount of Surface Pipe Set and Cemented at 201.23 feet
Multiple Stage Cementing Collar Used? Yes No
If yes, show depth set.....feet
If alternate 2 completion, cement circulated
from.....feet depth to.....w/.....SX cmt

API NO. 15-007-22,096
County Barber
140' S of
C.W/2..... Sec 5..... Twp 31S Rge 12W East West

2500 Ft North from Southeast Corner of Section
3960 Ft West from Southeast Corner of Section
(Note: Locate well in section plat below)


Lease Name Kumberg Well # 5-12

Field Name Northeast Nurse

Producing Formation N/A

Elevation: Ground 1789' KB 1794'

Section Plat

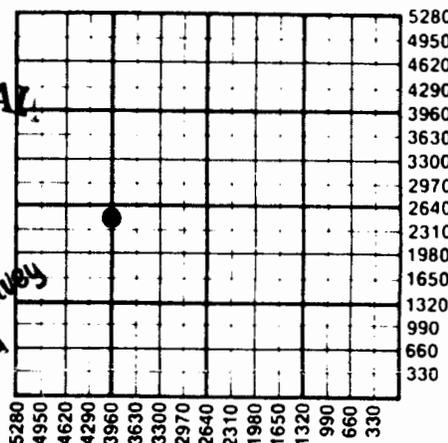

CONFIDENTIAL

DEC 30 1985

State Geological Survey
WICHITA BRANCH

WATER SUPPLY INFORMATION

Disposition of Produced Water: Disposal
Docket # Repressuring

Questions on this portion of the ACO-1 call:
Water Resources Board (913) 296-3717

Source of Water:
Division of Water Resources Permit #.....

Groundwater.....Ft North from Southeast Corner
(Well)Ft West from Southeast Corner of
Sec Twp Rge East West

Surface Water 800 Ft North from Southeast Corner
(Stream, pond etc) 600 Ft West from Southeast Corner
Sec 5 Twp 31S Rge 12 East West

Jim Keller, Sawyer, Ks. 67134
 Other (explain).....
(purchased from city, R.W.D. #)

INSTRUCTIONS: This form shall be completed in duplicate and filed with the Kansas Corporation Commission, 200 Colorado Derby Building, Wichita, Kansas 67202, within 90 days after completion or recompletion of any well. Rule 82-3-130 and 82-3-107 apply.
Information on side two of this form will be held confidential for a period of 12 months if requested

