Owner's Represent

LAUGHLIN-SIMMONS & CO. OF KANSAS, INC.
OILWELL ELEVATIONS AND LOCATIONS
2121 W. 18TH STREET (316) 943-5351
WICHITA, KANSAS 67203

March 4, 1975
DATE

Barber — COUNTY
8 — S
31s — T
12w — R
~~100' N~~ of NE NE SW — LOCATION

Glen Rupe — OPERATOR
1 — NO.
Gress — FARM

ELEVATION: 1732 Gr

Mr. Glen N. Rupe
925 Olive Garvey Building
Wichita, Kansas 67202

RECD ... 1975

SCALE: 2" = 1 Mile

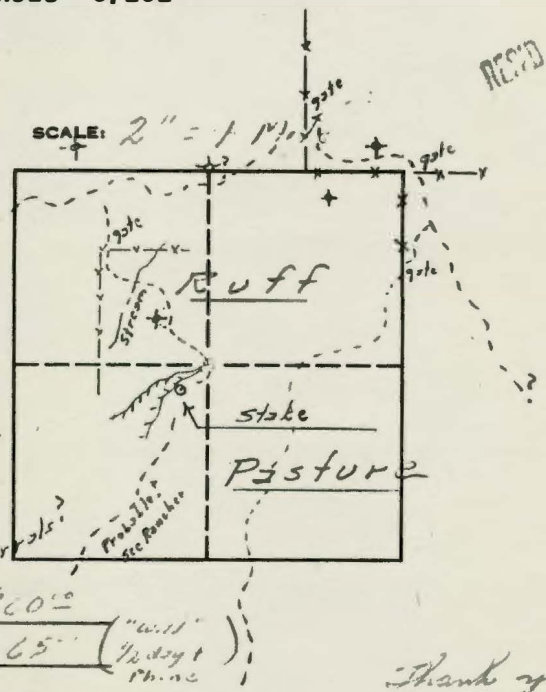

4' iron rod lath & flagging atop
1 wood stake

Level area - on ridge - 90 S of S. rim of deep ravine, (100' wide)

Rancher Gilbert Dawson advised of sth location. He will aid "cat" to spot

Union Dry also notified of sth & terrain
(Ruff-to-get-to)

MINIMUM STAKING CHARGE: $60.00
(INCLUDES GROUND ELEVATION)
EXTRA TIME & MILEAGE: $65.00 ("will" ½ day + Phone)
ELEVATION CHARGE:
TOTAL: $125.00

Thank you,
K. E. Moser
L-S SURVEYOR

Laughlin-Simmons & Co. of Kansas, Inc. is not liable in case of errors and/or ommissions.