


Barber

Section 12 Township 31 Range 13W

Well No. #1 Winter

Company Champlin Refining Company

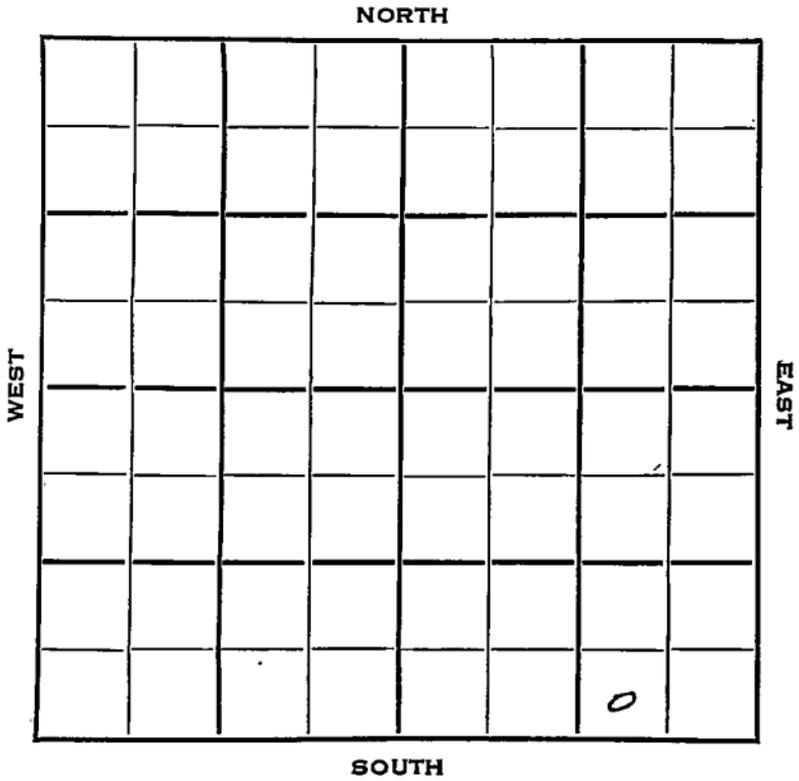

Sec. 12 Twp. 31 R. 13W

Well No. #1 Winter Farm

Champlin Refining Company Company

Contractor


_____ Ft. from N. Line

330 Ft. from S. Line

990 Ft. from E. Line

_____ Ft. from W. Line

SW SE SE

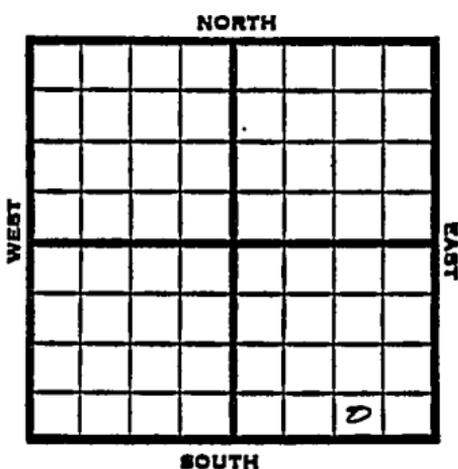

1953 Elev. 1598' REPORT

3/11 Location
 3/19 "
 3/26 10" @ 202
 DST 2575-2620, 1 hr, 2' M
 DST 2658-2715, 1 hr, 45' SW
 Drlg. 3190'
 4/2 Heeb 3475, Doug 3550
 DST 3536-65 2 Hrs. 1,250,000 gas in
 2 Hrs. 180' gassy m, 180' SW
 1225#
 TD 3620
 Schl 7" @ 3619'
 4/9 CO 3560
 43/3544-53, 1,100,000 gas + 4 BWPH
 4/15 Spud 3-16-53
 Gas Well
 TD 3620'
 10" @ 202'
 DST 2575-2620 open 1 hr. Rec 2' mud
 DST 2658-2715 open 1 hr, Rec 45' sw
 Heeb 3475, Doug 3550,
 DST 3536-65 open 2 hr. Rec 1,250,000
 gas in 2 hr. 180' gassy mud 180' sw
 1225#
 TD 3620'
 7" @ 3619'

OVER

1953

Information brought forward

4/15 CO to 3560
43/ 3544-53 1,100,000 gas 4 bwph
Comp. shut in gas well.

COMPLETED

Scout Cards
 Land Small Map
 and Wall Map
 Racings
 France Map
 Pierce Map
 Misc.

Handwritten scribbles

3

Scout 21 RVW

Prig. Data

Scout Cards
Land Small Map
Land Wall Map
Tracings
France Map
France Map
Misc.

APR 21 1952

Orig. Data