


Section 12 Township 31 Range 14W

Well No. #1, Lake

Company Cities Service

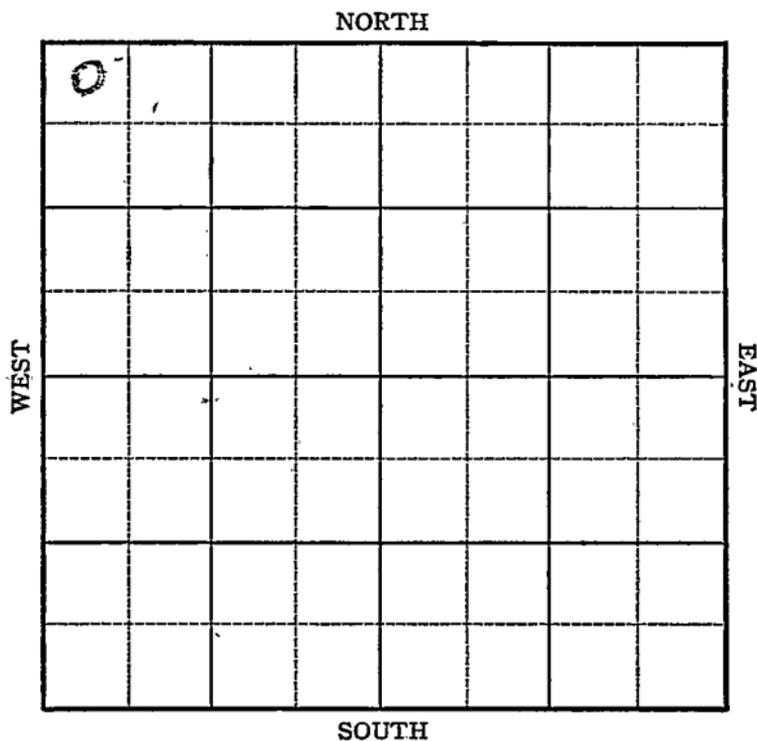

KANSAS

Barber County ✓

Sec. 12 Twp. 31 R. 14W

Well No. #1 Lake Farm

Cities Service Company

Hargis


330 Ft. from N. Line

Ft. from S. Line

Ft. from E. Line

330 Ft. from W. Line

NW/c

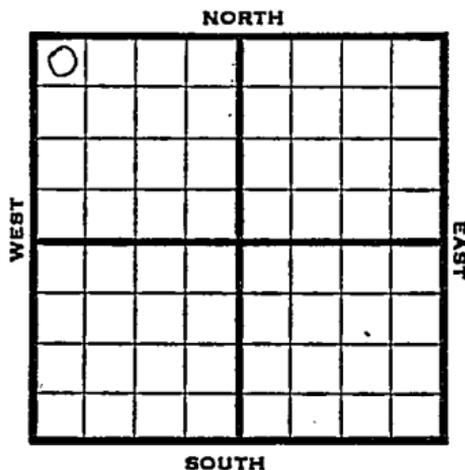

1946 Elev 1698' REPORT

4/10 RUR

4/16 8" @ 794 WOC

4/23 Drlg 2535'

5/1 Drlg 3535'

5/7 Drlg 4262'

5/14 Lans 3814  
Viola 4397  
Simp 4496  
Drlg 4563

5/21 Arb 4601  
4641 TD  
5" @ 4487  
RUST

5/29 90 shots 4390-4413  
4000 acid.  
Swb. 4 Wtr. per hr. 24 hrs.

6/5 PB 4373  
72 shots 3761-3781  
Wtr.

6/12 Arb 4601'  
TD 4641'

**ABANDONED**

KANSAS Kansas Pool Name Hargis

Map No. 93 Sec. 12 Twp. 31 R. 14W

Well No. 1 Lake

Cities Service Company

FIRST REPORT Contractor

NW/C

SECTION PLAT

330 Ft. from N. Line

\_\_\_\_\_ Ft. from S. Line

\_\_\_\_\_ Ft. from E. Line

330 Ft. from W. Line

0			

Barber County

Location \_\_\_\_\_

Rig up \_\_\_\_\_

Drilling and Remarks:

R U R

RECORD

Cased \_\_\_\_\_ in., \_\_\_\_\_ ft.

Sand \_\_\_\_\_

Gas \_\_\_\_\_

Oil \_\_\_\_\_

Total Depth \_\_\_\_\_

PRODUCTION

1st 24 hrs. Nat. \_\_\_\_\_

1st 24 hrs. after shot \_\_\_\_\_

Gas \_\_\_\_\_ Cu. Ft.

Dry Hole \_\_\_\_\_

Abandoned \_\_\_\_\_

Date

APR 10 1945 19

S. J. LEWIS Scout

KANSAS Pool Name Hargis Pool

Map No. 9.3 Sec. 12 Twp. 31 R. 14W

Well No. 1 Lake

Cities Service Company

**ABANDONED**

Contractor

NW/C

*E. J. 1698*

**SECTION FLAT**

330 Ft. from N. Line

\_\_\_\_\_ Ft. from S. Line

\_\_\_\_\_ Ft. from E. Line

330 Ft. from W. Line

0			

Barber County

Location \_\_\_\_\_

Rig up \_\_\_\_\_

Drilling and Remarks:

*CR 4601*

**RECORD**

Cased \_\_\_\_\_ in., \_\_\_\_\_ ft.

Sand \_\_\_\_\_

Gas \_\_\_\_\_

Oil \_\_\_\_\_

Total Depth 4641

**PRODUCTION**

1st 24 hrs. Nat. \_\_\_\_\_

1st 24 hrs. after shot \_\_\_\_\_

Gas \_\_\_\_\_ Cu. Ft.

Dry Hole \_\_\_\_\_

Abandoned \_\_\_\_\_

Date

JUN 12 1946 19 S. J. LEWIS Scout