


Section 12 Township 31 Range 36W

Well No. 1 Fineb-Hirz Unit

Company Magnolia

Hugoton Pool  
NORTH

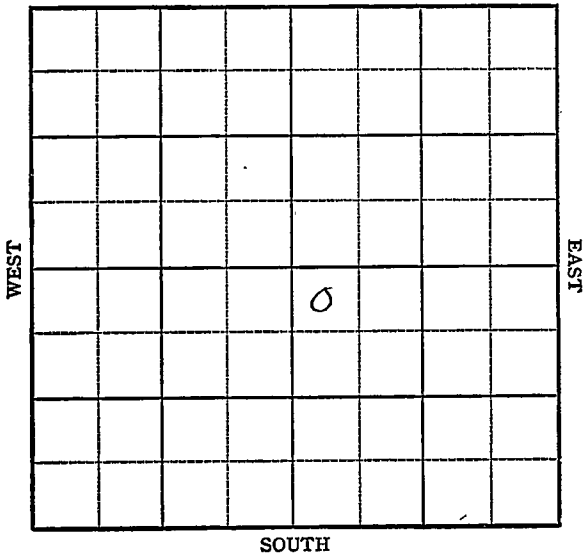

Sec. 12 Twp. 31 R. 36W

Well No. 1 Fineb-Hirz Unit Farm

Magnolia Pet. Company

Hugoton Pool


330 Ft. from N. Line

\_\_\_\_\_ Ft. from S. Line

\_\_\_\_\_ Ft. from E. Line

330 Ft. from W. Line

NW SE

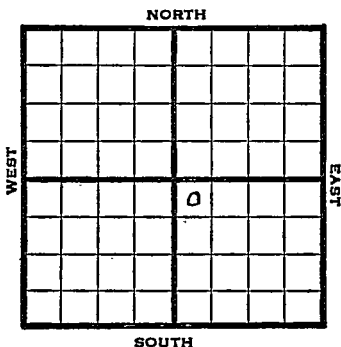

1948 Elev. 3025' REPORT

9/1 10" @ 666'  
Drlg 705'

9/8 Drlg. 2785'

9/14 TD 2800'  
7" @ 2799'

192 shots 2726-62 - 7000 acid  
96 " 2672-92 - " "

9/21 168 shots 2616-48 - 7000 acid  
48 " 2593-2602 " "

9/29 "

10/6 7" @ 2799'  
Perf.  
Acid 28,000  
Gas 13,600,000  
R. Pr. 391#  
TD 2800'

**COMPLETED**



Map No. \_\_\_\_\_ Sec. 12 Twp. 31 R. 36W

Well No. 1 Fineb - Hirz Unit

Magnolia \_\_\_\_\_ Company

COMPLETE

Contractor

NW SE

E 1,5025

SECTION PLAT

330 Ft. from N. Line

\_\_\_\_\_ Ft. from S. Line

\_\_\_\_\_ Ft. from E. Line

330 Ft. from W. Line

		o	

Stevens County

Location \_\_\_\_\_

Rig up \_\_\_\_\_

Drilling and Remarks:

7" @ 2799

Perf.

2800000 acc'd

13,600,000 Gae

291 #RR

RECORD

Cased \_\_\_\_\_ in., \_\_\_\_\_ ft.

Sand \_\_\_\_\_

Gas \_\_\_\_\_

Oil \_\_\_\_\_

Total Depth 2800

PRODUCTION

1st 24 hrs. Nat. \_\_\_\_\_

1st 24 hrs. after shot \_\_\_\_\_

Gas \_\_\_\_\_ Cu. Ft.

Dry Hole \_\_\_\_\_

Abandoned \_\_\_\_\_

Date

OCT 6 1948 19

S. I. LEWIS Scout