


Section 12 Township 31 Range 34W

Well No. 1 Swink

Company Cities Service

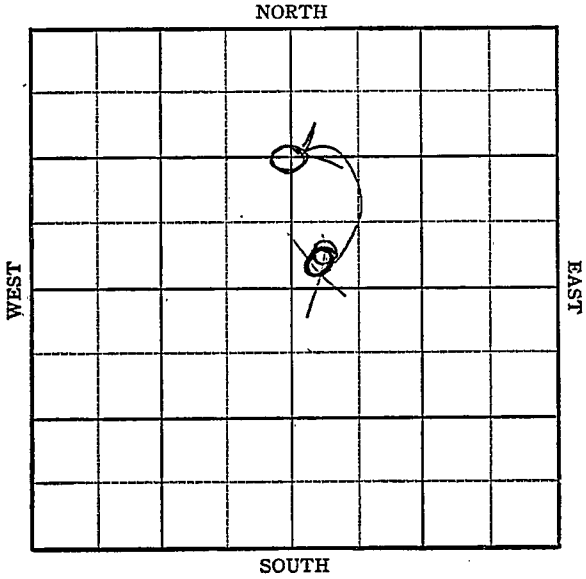

Sec. 12 Twp. 31 R. 34-W ✓

Well No. #1 Swink Farm

Cities Service Company

Hugoton


1320 Ft. from N. Line

70 Ft. from S. Line

2640 Ft. from E. Line

150 Ft. from W. Line

~~SW NE~~ 2 1/2 Sec.

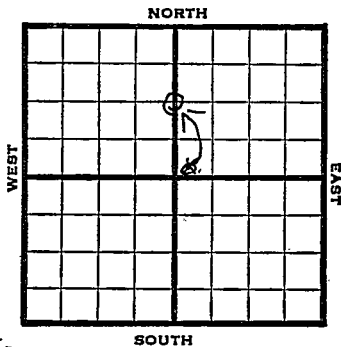

1948		REPORT
	Eliv. 2942'	
8/11	8" @ 640'	
	Drlg 1500'	
8/18	Drlg 2642'	
8/26	TD 2801	
	5" @ 2800'	
9/1	"	
9/8	140 shots 2736-64 - 1500 acid	
9/14	50 shots 2578-88	
	134 " 2678-2704	
	150 " 2634-64	
	50 " 2602-12 - 20,000 acid	
9/21	"	
9/29	9000 acid	
10/6	5" @ 2800'	
	Perf.	
	Acid 36,000	
	Gas 16,600,000	
	R. Pr. 358#	
	TD 2801'	

COMPLETED

Seward County Kansas State

Map No. _____ Sec. 12 Twp. 31 R. 34W

Well No. 1 Swink

Cities Service Company

FIRST REPORT

Contractor

SW NE

SECTION PLAT

_____ Ft. from N. Line

70 Ft. from S. Line


_____ Ft. from E. Line

150 Ft. from W. Line

Hugoton Pool

Remarks:

8" @ 640 drlg. 1500

 

Date
AUG 1 1 1948


Scout **S. J. LEWIS**





 






Misc. Small Maps

Cards

Tracing

France Map

Scarborough Map

Pierce Map

Geological Dept.

Pierce Plat Book



Seward County Kansas State

Map No. _____ Sec. 12 Twp. 31 R. 34W


Well No. 1 Swink

Cities Service Company

CORRECTION Contractor

C $N\frac{1}{2}$ Sec.

SECTION PLAT

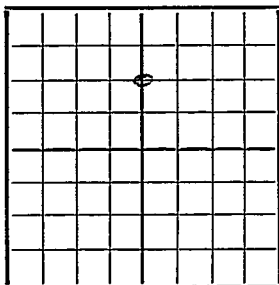

1320 Ft. from N. Line

_____ Ft. from S. Line

2640 Ft. from E. Line

_____ Ft. from W. Line

Hugoton Pool

Remarks:

Reported SW NE

Date


AUG 18 1948

Scout

S. J. LEWIS



 

Faint, illegible text to the right of the grid, possibly bleed-through from the reverse side.

- Misc. Small Maps _____
- Cards Edith
- Tracing _____
- France Map ✓
- Scarborough Map ✓
- Fig. 69 Map _____
- Geological Dept. _____
- Pierce Plat Book _____

Map No. _____ Sec. 12 Twp. 31 R. 34^W

Well No. 1 Swink

Cities Service Company

COMPLETE Contractor

C N¹/₂ Sec.

E 1,2942
SECTION PLAT

1320 Ft. from N. Line

_____ Ft. from S. Line

2640 Ft. from E. Line

_____ Ft. from W. Line

Seward County

Location _____

Rig up _____

Drilling and Remarks:

5" @ 2500
Perf.
36000000 gal
16,600,000 gal
258 RB

RECORD

Cased _____ in., _____ ft.

Sand _____

Gas _____

Oil _____

Total Depth 2801

PRODUCTION

1st 24 hrs. Nat. _____

1st 24 hrs. after shot _____

Gas _____ Cu. Ft.

Dry Hole _____

Abandoned _____

Date

OCT 6 1948 19 S. J. LEWIS Scout


Map No. 15

Well No.




 







- Misc. Small Maps
- Cards
- Tracing
- France Map
- Scarborough Map
- Pierce Map
- Geological Dept.
- Pierce Plat Book


Date